

LINCOLN
M 2010
5/6/77

MISSISSIPPI
 BOARD OF WATER COMMISSIONERS
 416 North State Street
 132L Jackson, Mississippi 39201

WATER WELL DRILLERS LOG

May 6 1977 Genn Water Well Cont. Lincoln
 date well completed firm name county well located


LANDOWNER:	description of formations encountered	from	to
Connie Mack Douglas Route 4, Box 116 Brookhaven, Miss. (mailing address)	Citronelle	1	61
WELL LOCATION: sec. <u>11</u> T <u>6</u> N R <u>8</u> E --S-- --W-- <u>7</u> miles <u>NE</u> of <u>Bogue Chitto</u> (distance) (direction) (nearest town)			
WELL PURPOSE: <u>home</u> (home, irrigation, municipal, industrial)			
WELL COMPLETION DATA: (1) diameter (inches) <u>6</u> (2) total depth (feet) <u>61</u> (3) static water level (feet) <u>27</u> <u>below</u> <u>above</u> top of ground. (4) casing <u>PVC</u> <u>49</u> (material) (depth) <u>4"</u> (size) if telescope see back. (5) screen <u>PVC</u> <u>49'</u> (length) (depth to top) <u>010</u> <u>PVC</u> (size) (material) (6) pump <u>1 1/2</u> sub <u>10</u> (HP) (yield gpm) <u>electricity</u> (type power) (7) electric log <u>no</u> (yes or no) (organization running log) (8) how well bottom plugged <u>back wash valve</u>			
DRILLERS REMARKS:			

RECEIVED
 JUN 14 1977

MISS. Bd. of Water Comm.

If well telescopes please sketch and show depths.

GROUND LEVEL

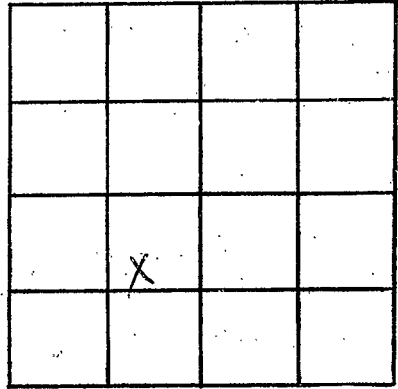

SECTION 11

Please indicate well location X.

ADDITIONAL INFORMATION

If more than one screen,
show locations of each on sketch.