

Lincoln  
 M 2012  
 6-24-77

MISSISSIPPI  
 BOARD OF WATER COMMISSIONERS  
 416 North State Street  
 Jackson, Mississippi 39201

WATER WELL DRILLERS LOG

June 24 1977 McCOVINGTON Lincoln  
 date well completed firm name county well located

LANDOWNER: Kioth Southern  
Bopechitto  
 (mailing address)

description of formations encountered	from	to
CLAY	0	23
SANDY CLAY	23	70
CLAY	70	82
SAND & ROCK	82	94
SAND	94	104

WELL LOCATION:  
 sec. 35 T. 6 N. R. 8 E  
X 4 1/2 miles E of Boyer, Chilton  
 (distance) (direction) (nearest town)

WELL PURPOSE: Home  
 (home, irrigation, municipal, industrial)


- WELL COMPLETION DATA:
- (1) diameter (inches) 4"
  - (2) total depth (feet) 104'
  - (3) static water level (feet) 90 below top of ground.
  - (4) casing Plastic, 94'  
 (material) (depth)  
4" if telescope see back.  
 (size)
  - (5) screen 10', 94'  
 (length) (depth to top)  
4", Plastic  
 (size) (material)
  - (6) pump 1/2, 6  
 (HP) (yield gpm)
  - (type power)
  - (7) electric log no  
 (yes or no)
  - (organization running log)
  - (8) how well bottom plugged wood

DRILLERS REMARKS:

RECEIVED  
 AUG 10 1977

If well telescopes please sketch and show depths.

GROUND LEVEL

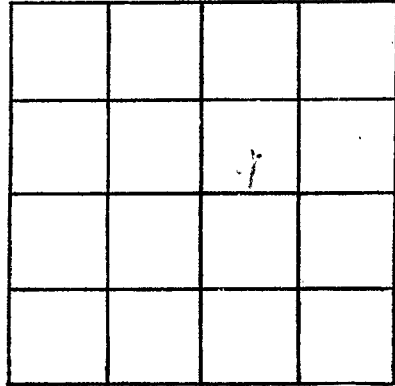

SECTION 35

Please indicate well location X.

ADDITIONAL INFORMATION

If more than one screen, show locations of each on sketch.