

Lincoln  
M 2013  
7-28-77

MISSISSIPPI  
BOARD OF WATER COMMISSIONERS  
416 North State Street  
Jackson, Mississippi 39201

134

WATER WELL DRILLERS LOG

July 28 19 77 Grenn Water Well Cont. Lincoln  
date well completed firm name county well located

LANDOWNER: J.E. Smallwood Route 4, Box 106 Brookhaven, Miss. (mailing address)	description of fomations encountered citronelle	from 1	to 86
<b>WELL LOCATION:</b> sec. <u>12</u> T. <u>6</u> N. R. <u>8</u> E. 5 miles SE of Brookhaven (distance) (direction) (nearest town)			
<b>WELL PURPOSE:</b> home (home, irrigation, municipal, industrial)			
<b>WELL COMPLETION DATA:</b> (1) diameter (inches) <u>6</u> (2) total depth (feet) <u>86</u> (3) static water level (feet) <u>50</u> below top of ground. (4) casing <u>PVC</u> <u>80</u> (material) (depth) <u>4"</u> if telescope see back. (size) (5) screen <u>6'</u> <u>80'</u> (length) (depth to top) <u>.010</u> <u>PVC</u> (size) (material) (6) pump <u>1/2 HP</u> <u>sub 10</u> (HP) (yield gpm) <u>electricity</u> (type power) (7) electric log <u>no</u> (yes or no)			
(organization running log)			
(8) how well bottom plugged <u>back wash valve</u>			
<b>DRILLERS REMARKS:</b>			


RECEIVED

AUG 24 1977

MISS. RD. OF WATER COMMISSIONERS

If well telescopes please sketch and show depths.

GROUND LEVEL

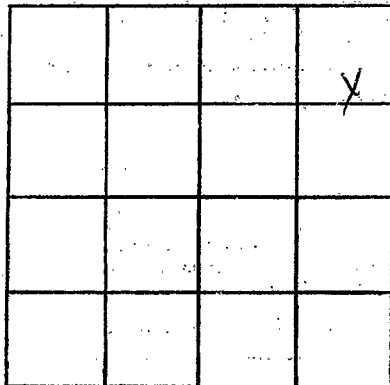

SECTION 12

Please indicate well location X.

ADDITIONAL INFORMATION

If more than one screen, show locations of each on sketch.