

Lincoln
M 2014
8-4-77

MISSISSIPPI
 BOARD OF WATER COMMISSIONERS
 416 North State Street
 Jackson, Mississippi 39201

WATER WELL DRILLERS LOG

XV Aug. 4 1977 77 Grenn Water Well Cont. Lincoln
 date well completed firm name county well located

LANDOWNER: <u>Ronnie Herröng</u>	description of fomations encountered	from	to
<u>Route 2</u>			
<u>Bogue Chitto, Miss.</u>			
(mailing address)			
WELL LOCATION:			
sec. <u>6</u> T. <u>6</u> <u>N</u> R. <u>8</u> <u>E</u>			
<u>4</u> miles <u>S</u> of <u>Brookhaven</u>			
(distance) (direction) (nearest town)			
WELL PURPOSE: <u>home</u>			
(home, irrigation, municipal, industrial)			
WELL COMPLETION DATA:			
(1) diameter (inches) <u>6</u>			
(2) total depth (feet) <u>75</u>			
(3) static water level (feet) <u>54</u> below top of ground.			
(4) casing <u>PVC</u> <u>63</u>			
(material) (depth)			
<u>4"</u> if telescope see back.			
(size)			
(5) screen <u>12'</u> <u>63'</u>			
(length) (depth to top)			
<u>.010</u> <u>PVC</u>			
(size) (material)			
(6) pump <u>1 1/2</u> HP sub <u>10</u>			
(HP) (yield gpm)			
<u>electricity</u>			
(type power)			
(7) electric log <u>no</u>			
(yes or no)			
(organization running log)			
(8) how well bottom plugged <u>back wash valve</u>			
DRILLERS REMARKS:			


RECEIVED

AUG 24 1977

MISS. BD. OF WATER COMMISSIONERS

If well telescopes please sketch and show depths.

GROUND LEVEL

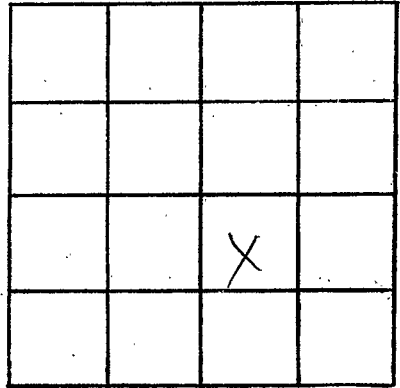

SECTION 6

Please indicate well location X.

ADDITIONAL INFORMATION

If more than one screen, show locations of each on sketch.