

LINCOLN

M 2015

11-21-78

MISSISSIPPI BOARD OF WATER COMMISSIONERS 416 North State Street Jackson, Mississippi 39201

WATER WELL DRILLERS LOG

11-21-78 date well completed 1978 firm name F. Samuel Cell Co. Lincoln county well located

LANDOWNER:

Jimmy Wilkinson R.R. Boque Clatto (mailing address)

description of formations encountered

from to

Red clay 0 20 Red sand 20 30 Coarse sand & gravel 30 108

WELL LOCATION:

sec. 36 T. 6 N R. 8 E 9 miles ESE of Boque Clatto (distance) (direction) (nearest town)

WELL PURPOSE: Home (home, irrigation, municipal, industrial)

WELL COMPLETION DATA:

- (1) diameter (inches) 4
(2) total depth (feet) 108
(3) static water level (feet) 60 below top of ground.
(4) casing (material) PVC, (depth) 100, (size) 4 if telescope see back.
(5) screen (length) 8, (depth to top) 100, (size) 4, (material) PVC
(6) pump 1/2 (HP), 10 (yield gpm), (type power) elec
(7) electric log No (yes or no)
(8) how well bottom plugged Seal blk

RECEIVED


DEC - 7 1978

DRILLERS REMARKS:

MISS. BO. OF WATER COMMISSIONERS

If well telescopes please sketch and show depths.

GROUND LEVEL

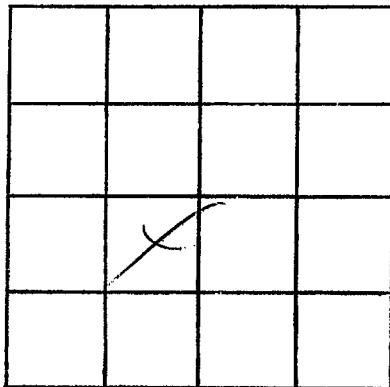

SECTION 36

Please indicate well location X.

ADDITIONAL INFORMATION

If more than one screen, show locations of each on sketch.