

LINCOLN

M 2016

1-11-78

MISSISSIPPI BOARD OF WATER COMMISSIONERS
416 North State Street
Jackson, Mississippi 39201

WATER WELL DRILLERS LOG

Jan 11
date well completed

Reines Well Service
firm name

Lincoln
county well located

LANDOWNER:	description of formations encountered	from	to
Charles Hart	Clay	0	12
Rt. Bogue Chitto (mailing address)	Coarse sand	12	58
	Sand pack	58	59
	Gravel	59	69
	Hard blue Chalk	69	235
	Coarse sand	235	264

WELL LOCATION:

sec 31 T 6 N R 8 E

2 miles N-NE of Bogue Chitto
(distance) (direction) (nearest town)

WELL PURPOSE: Trailer
(home, irrigation, municipal, industrial)

WELL COMPLETION DATA:

- (1) diameter (inches) 4"
- (2) total depth (feet) 264
- (3) static water level (feet) 76 below top of ground.
- (4) casing plastic bottom
(material) (depth)
- (5) screen 10' 254
(length) (depth to top)
- (6) pump 4" 3/4 HP 6
(size) (material) (yield gpm)
- (7) electric log no
(yes or no)

(8) how well bottom plugged:
Wooden Plug


DRILLERS REMARKS:

RECEIVED

MAY 11 1978

If well telescopes please sketch and show depths.

GROUND LEVEL

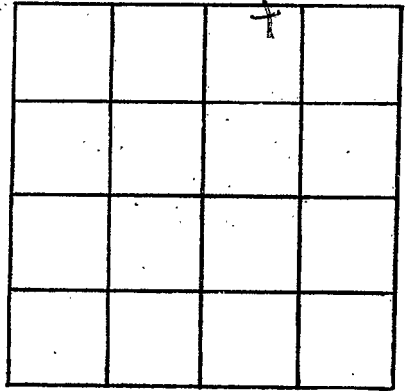

SECTION 31

Please indicate well location X.

ADDITIONAL INFORMATION

If more than one screen,
show locations of each on sketch.