

LINCOLN
M 2017
12-12-78

**MISSISSIPPI
BOARD OF WATER COMMISSIONERS**
416 North State Street
Jackson, Mississippi 39201

WATER WELL DRILLERS LOG

Dec. 12 19 78 Green Water Well Cont. Lincoln
 date well completed firm name county well located

LANDOWNER: <u>Pete Oliver</u> <u>Rt. 6</u>	description of formations encountered	from	to
<u>Brookhaven, Miss.</u> (mailing address)	<u>Citronelle</u>	<u>1</u>	<u>70</u>
WELL LOCATION:			
sec. <u>23</u> T. <u>6</u> N R. <u>8</u> E <u>4</u> <u>?</u> miles (NE) <u>?</u> <u>SE</u> of <u>Brookhaven</u> (distance) (direction) (nearest town)			
WELL PURPOSE: <u>home</u> (home, irrigation, municipal, industrial)			
WELL COMPLETION DATA:			
(1) diameter (inches) <u>4</u>			
(2) total depth (feet) <u>70</u>			
(3) static water level (feet) <u>32</u> below top of ground.			
(4) casing <u>PVC</u> <u>58'</u> (material) (depth) <u>4"</u> (size) if telescope see back.			
(5) screen <u>12'</u> <u>58'</u> (length) (depth to top)			
<u>.010</u> <u>PVC</u> (size) (material)			
(6) pump <u>did not install</u> (HP) (yield gpm)			
(type power)			
(7) electric log <u>no</u> (yes or no)			
(organization running log)			
(8) how well bottom plugged <u>back wash valve</u>			
DRILLERS REMARKS:			


Miss. Board of Water Comm.

FEB 6 1979

RECEIVED

If well telescopes please sketch and show depths.

GROUND LEVEL

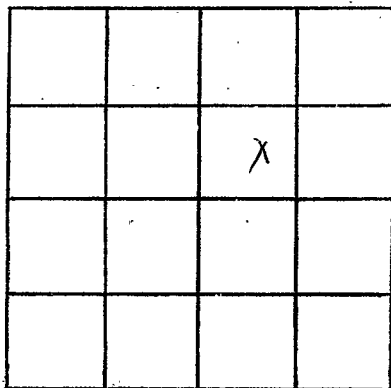

SECTION 23

Please indicate well location X.

ADDITIONAL INFORMATION

If more than one screen, show locations of each on sketch.