

LINCOLN
M 2018
9-03-78

MISSISSIPPI
 BOARD OF WATER COMMISSIONERS
 416 North State Street
 Jackson, Mississippi 39201

WATER WELL DRILLERS LOG

Sept 3 1978 Prews Well Co Lincoln
 date well completed firm name county well located

LANDOWNER:
 John H. Bristle
 Rt 2 Ruth
 (mailing address)

WELL LOCATION:
 sec. 13 T 6 N R 8 E
 8 miles north of Ruth
 (distance) (direction) (nearest town)

WELL PURPOSE: Trailer
 (home, irrigation, municipal, industrial)

WELL COMPLETION DATA:

(1) diameter (inches) 4"

(2) total depth (feet) 75

(3) static water level (feet) 58 below top of ground.

(4) casing plastic bottom
 (material) (depth)

_____ If telescope see back.
 (size)

(5) screen 5' 73'
 (length) (depth to top)

4" plastic
 (size) (material)

(6) pump perathers
 (HP) (yield gpm)

_____ (type power)

(7) electric log no
 (yes or no)

_____ (organization running log)

description of formations encountered	from	to
Red sandy clay	0	17
Red sand	17	50
Sand Rock	50	51
gravel	57	57
pink Chalk	57	65
Red gravel + sand	65	78


(8) how well bottom plugged
Wooden plug

DRILLERS REMARKS:
A

RECEIVED
 JAN 15 1978
 MISS. BD. OF WATER COMM

If well telescopes please sketch and show depths.

GROUND LEVEL

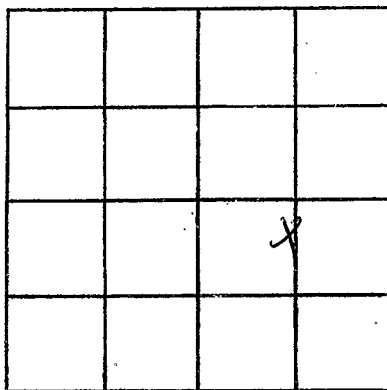

SECTION 13

Please indicate well location X.

ADDITIONAL INFORMATION

If more than one screen,
show locations of each on sketch.