

LINCOLN
M <u>2020</u>
2-26-79

**MISSISSIPPI
BOARD OF WATER COMMISSIONERS**
416 North State Street
Jackson, Mississippi 39201

WATER WELL DRILLERS LOG

Feb. 26 1979 Grenn Water Well Cont. Lincoln
 date well completed firm name county well located

LANDOWNER: Bruce Coghlan Route 4, Box 300 A Brookhaven, Miss. (mailing address)	description of formations encountered	from	to
WELL LOCATION: sec. <u>3</u> T <u>6</u> N R <u>8</u> E 4 SE Bogue Chitto (distance) (direction) (nearest town)			
WELL PURPOSE: home (home, irrigation, municipal, industrial)			
WELL COMPLETION DATA:			
(1) diameter (inches) <u>4</u>			
(2) total depth (feet) <u>92</u>			
(3) static water level (feet) <u>60</u> below top of ground.			
(4) casing <u>PVC</u> <u>80'</u> (material) (depth) <u>4"</u> (size) if telescope see back.			
(5) screen <u>12'</u> <u>80'</u> (length) (depth to top) <u>.010</u> <u>PVC</u> (size) (material)			
(6) pump <u>did not install</u> (HP) (yield gpm)			
(7) electric log <u>no</u> (yes or no)			
(8) how well bottom plugged <u>back wash valve</u>			
DRILLERS REMARKS:			


Miss. Board of Water Comm.

MAR 9 - 1979

RECEIVED

If well telescopes please sketch and show depths.

GROUND LEVEL

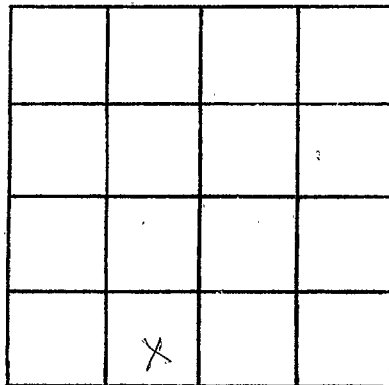

SECTION 3

Please indicate well location X.

ADDITIONAL INFORMATION

If more than one screen, show locations of each on sketch.