

LINCOLN
M 2021
03-30-79

**MISSISSIPPI
BOARD OF WATER COMMISSIONERS**
416 North State Street
Jackson, Mississippi 39201

WATER WELL DRILLERS LOG

March 30 19 79 Grenn Water Wel 1 Lincoln
 date well completed firm name county well located

LANDOWNER:	description of formations encountered	from	to
Enterprise School Route 4 Brookhaven, Ms. 39601 (mailing address)	Citronelle	1	152
WELL LOCATION:			
sec. 22 T. 6 N R. 8 E S W			
8 miles SE of Brookhaven (distance) (direction) (nearest town)			
WELL PURPOSE: SCHOOL (home, irrigation, municipal, industrial)			
WELL COMPLETION DATA:			
(1) diameter (inches) 4			
(2) total depth (feet) 152			
(3) static water level (feet) 50 below top of ground.			
(4) casing PVC, 140' (material) (depth) 4" (size) if telescope see back.			
(5) screen 12', 140' (length) (depth to top) .010 PVC (size) (material)			
(6) pump 1 sub 10 (HP) (yield gpm) electricity (type power)			
(7) electric log no (yes or no) (organization running log)			
(8) how well bottom plugged backwash valve			
DRILLERS REMARKS:			


Miss. Board of Water Comm.

MAY 9 1979

RECEIVED

If well telescopes please sketch and show depths.

GROUND LEVEL

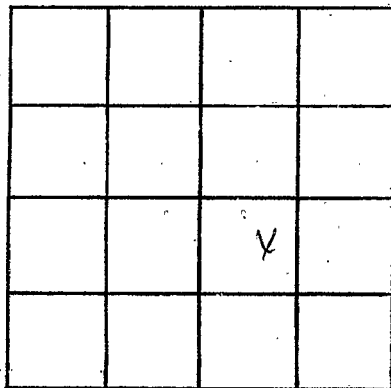

SECTION 22

Please indicate well location X.

ADDITIONAL INFORMATION

If more than one screen,
show locations of each on sketch.