

LINCOLN
M 2022
5-4-79

MISSISSIPPI
BOARD OF WATER COMMISSIONERS
416 North State Street
Jackson, Mississippi 39201

WATER WELL DRILLERS LOG


May 4 1979 Grenn Water Well Cont. Lincoln
date well completed firm name county well located

LANDOWNER:	description of formations encountered	from	to
Henry Busby	Citronelle	1	92
Route 2			
Bogue Chitto, Miss. (mailing address)			
WELL LOCATION:			
sec. 14 T 6 R 8 5 miles NE of Bogue Chitto (distance) (direction) (nearest town)			
WELL PURPOSE: home (home, irrigation, municipal, industrial)			
WELL COMPLETION DATA:			
(1) diameter (inches) 4"			
(2) total depth (feet) 92			
(3) static water level (feet) 60 below top of ground.			
(4) casing PVC 80' (material) (depth) 4" (size) If telescope see back.			
(5) screen 12' 80' (length) (depth to top) .010 pvc (size) (material)			
(6) pump did not install (HP) (yield gpm)			
(type power)			
(7) electric log no (yes or no)			
(organization running log)			
(8) how well bottom plugged backwash valve			
DRILLERS REMARKS:			

Miss. Board of Water
JUL 9 1979
RECEIVED

If well telescopes please sketch and show depths.

GROUND LEVEL

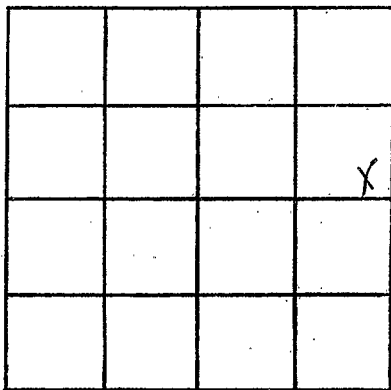

SECTION 14

Please indicate well location X.

ADDITIONAL INFORMATION

If more than one screen, show locations of each on sketch.