

Lincoln
M 2025
9-24-79

MISSISSIPPI
BOARD OF WATER COMMISSIONERS
416 North State Street
Jackson, Mississippi 39201

WATER WELL DRILLERS LOG

Sept. 24 1979 Grenn Water Well Cont. Lincoln
date well completed firm name county well located

LANDOWNER: Gary Myers Rt. 2, Bogue Chitto, Mss. (mailing address)	description of formations encountered	from	to
	Clay	1	15
	sand	15	42
	white clay	42	65
	blue clay	65	170
	white clay	170	180
	sand	180	240
WELL LOCATION: sec. 6 T. 6 N. R. 8 E 4 miles S of Brookhaven (distance) (direction) (nearest town)			
WELL PURPOSE: & home (home, irrigation, municipal, industrial)			
WELL COMPLETION DATA: (1) diameter (inches) 6 (2) total depth (feet) 240 (3) static water level (feet) 70 below top of ground. (4) casing PVC, 230 (material), (depth), 4" (size) if telescope see back. (5) screen 10' (length), 230' (depth to top), .010 PVC (size), (material) (6) pump 1/2 sub 8 (HP), (yield gpm) electricity (type power) (7) electric log no (yes or no) (organization running log) (8) how well bottom plugged back wash valve			
DRILLERS REMARKS:			


DEPT. OF NATURAL RESOURCES
BUREAU OF LAND & WATER RESOURCES

NOV 20 1979

RECEIVED

If well telescopes please sketch and show depths.

GROUND LEVEL

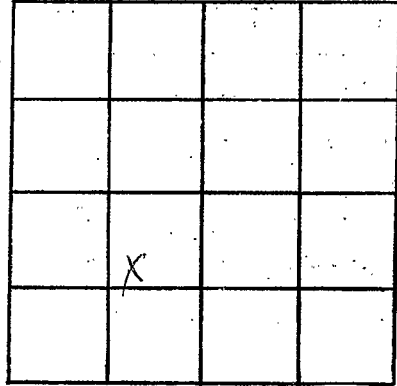

SECTION 6

Please indicate well location X.

ADDITIONAL INFORMATION

If more than one screen, show locations of each on sketch.