

LINCOLN

M 2027
6-18-80

**MISSISSIPPI  
BOARD OF WATER COMMISSIONERS**  
416 North State Street  
Jackson, Mississippi 39201

**WATER WELL DRILLERS LOG**

June 18 1980 Grenn Water Well Cont. Lincoln  
 date well completed firm name county well located

**LANDOWNER:** Dan L. Marshall  
 Route 2,  
 Bogue Chitto, Ms.  
 (mailing address)

description of formations encountered	from	to
Citronelle	1	80

**WELL LOCATION:**  
 sec. 6 T 6 N R 8 E  
 S W  
 4 miles S of Brookhaven  
 (distance) (direction) (nearest town)

**WELL PURPOSE:** home  
 (home, irrigation, municipal, industrial)

- WELL COMPLETION DATA:**
- (1) diameter (inches) 4
  - (2) total depth (feet) 80
  - (3) static water level (feet) 60 below top of ground.
  - (4) casing PVC, 70',  
 4" (material) (depth)  
 (size) If telescope see back.
  - (5) screen 10', 70'  
 (length) (depth to top)  
 .010 PVCC  
 (size) (material)
  - (6) pump 1 HP 19  
 (HP) (yield gpm)  
 electricity  
 (type power)
  - (7) electric log no  
 (yes or no)  
 (organization running log)

(8) how well bottom plugged  
 back wash valve

**DRILLERS REMARKS:**


DEPT. OF NATURAL RESOURCES  
 BUREAU OF LAND & WATER RESOURCES

JUN 30 1980

**RECEIVED**

If well telescopes please sketch and show depths.

GROUND LEVEL

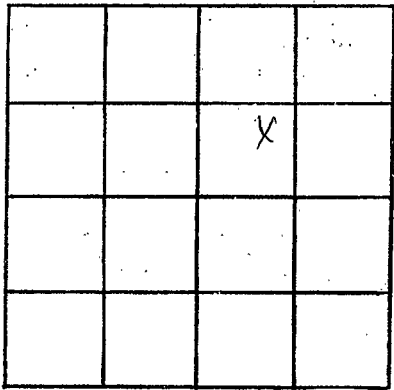

SECTION 6

Please indicate well location X.

ADDITIONAL INFORMATION

Lined area for additional information.

If more than one screen, show locations of each on sketch.