

LEWIS

M 2028

9-19-79

Sept-9

MISSISSIPPI
 BOARD OF WATER COMMISSIONERS
 416 North State Street
 Jackson, Mississippi 39201

WATER WELL DRILLERS LOG

19 *79* *Reems Well Co* *Lincoln*
 date well completed firm name county well located

LANDOWNER:
Miles Summers
At 1 Ruth
 (mailing address)

description of formations encountered	from	to
	<i>clay</i>	<i>0</i>
<i>red sand</i>	<i>17</i>	<i>70</i>
<i>per ground level</i>	<i>70</i>	<i>78</i>

WELL LOCATION:
 sec. *12* T. *6* N. R. *8* E
7 1/2 miles *S-SE* of *Brookhaven*
 (distance) (direction) (nearest town)

WELL PURPOSE: *house*
 (home, irrigation, municipal, industrial)

- WELL COMPLETION DATA:
- (1) diameter (inches) *4"*
 - (2) total depth (feet) *78'*
 - (3) static water level (feet) *61* below above top of ground.
 - (4) casing *plastic bottom*
 (material) (depth)
 - (size) If telescope see back.
 - (5) screen *5'* *73'*
 (length) (depth to top)
 - 4'* *plastic*
 (size) (material)
 - (6) pump *1/2* *10*
 (HP) (yield gpm)
 - elect*
 (type power)
 - (7) electric log *no*
 (yes or no)
 - (organization running log)

(8) how well bottom plugged:
wood plug

DRILLERS REMARKS:


DEPT. OF NATURAL RESOURCES
 BUREAU OF LAND & WATER RESOURCES

JUN 25 1980

RECEIVED

If well telescopes please sketch and show depths.

GROUND LEVEL

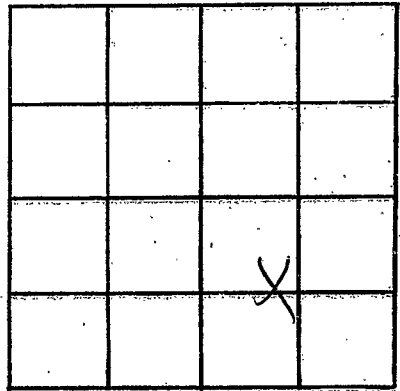

SECTION 12

Please indicate well location X.

ADDITIONAL INFORMATION

If more than one screen, show locations of each on sketch.