

LINCOLN
M 2029
6-30-80

MISSISSIPPI
BOARD OF WATER COMMISSIONERS
416 North State Street
Jackson, Mississippi 39201

WATER WELL DRILLERS LOG

June 30 1980 Grenn Water Well Cont. Lincoln
date well completed firm name county well located

LANDOWNER:	description of fomations encountered	from	to
Charles R. Griffin, Jr. Route 2, Box 286 B Bogue Chitto, Ms. (mailing address)	Citronelle	1	68
WELL LOCATION:			
sec. 32 T-6 ^N R-8 ^E 2 miles E. of Bogue Chitto (distance) (direction) (nearest town)			
WELL PURPOSE: home (home, irrigation, municipal, industrial)			
WELL COMPLETION DATA:			
(1) diameter (inches) 4 68'			
(2) total depth (feet) 68'			
(3) static water level (feet) 33 below top of ground.			
(4) casing PVC 58' (material) (depth) 4" if telescope see back. (size)			
(5) screen 10' 58' (length) (depth to top) , 010 PVC (size) (material)			
(6) pump 1/2 sub 8 (HP) (yield gpm) electricity (type power)			
(7) electric log no (yes or no) (organization running log)			
(8) how well bottom plugged backwash valve			
DRILLERS REMARKS:			


DEPT. OF NATURAL RESOURCES
BUREAU OF LAND & WATER RESOURCES

AUG 19 1980

RECEIVED

If well telescopes please sketch and show depths.

GROUND LEVEL

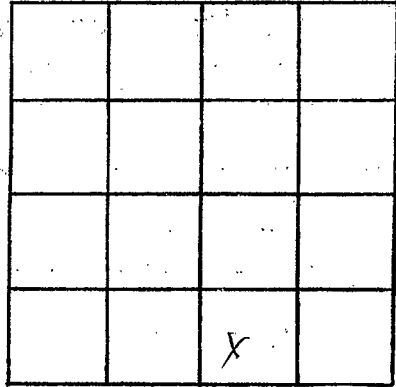

SECTION 32

Please indicate well location X.

ADDITIONAL INFORMATION

If more than one screen,
show locations of each on sketch.