

Lincoln  
M. 2031  
7-1-80  
July 1 1980  
date well completed

MISSISSIPPI  
BOARD OF WATER COMMISSIONERS  
416 North State Street  
Jackson, Mississippi 39201




WATER WELL DRILLERS LOG

Reynolds Ser. Lincoln  
firm name county well located


LANDOWNER:	description of formations encountered	from	to
Charles Boyd Mt Ruth (mailing address)			
WELL LOCATION: sec. 36 T. 6 N. R. 8 E 5 miles WINW of Ruth (distance) (direction) (nearest town)			
WELL PURPOSE: home (home, irrigation, municipal, industrial)			
WELL COMPLETION DATA:			
(1) diameter (inches) 4"			
(2) total depth (feet) 110			
(3) static water level (feet) 50 below top of ground			
(4) casing plastic bottom (material) (depth)			
(size) if telescope see back.			
(5) screen 5' 105' (length) (depth to top)			
4" plastic (size) (material)			
(6) pump by others (HP) (yield gpm)			
shot (type power)			
(7) electric log no (yes or no)			
(organization running log)			
(8) how well bottom plugged back wash valve			
DRILLERS REMARKS: ✓			

DEPT. OF NATURAL RESOURCES  
BUREAU OF LAND & WATER RESOURCES

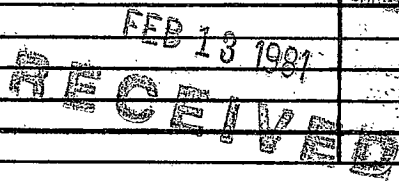

If well telescopes please sketch and show depths.

GROUND LEVEL

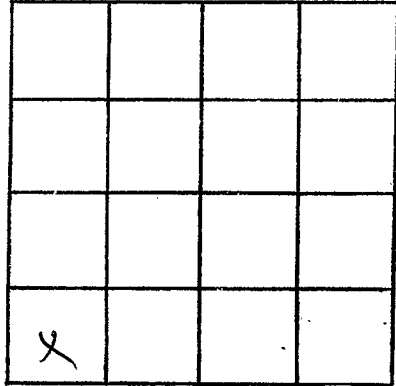

SECTION 56

Please indicate well location X.

ADDITIONAL INFORMATION

If more than one screen, show locations of each on sketch.