

Lincoln
M 2032

MISSISSIPPI
 BOARD OF WATER COMMISSIONERS
 416 North State Street
 Jackson, Mississippi 39201

WATER WELL DRILLERS LOG

July 8 1980 Grenn Water Well Cont. Lincoln
 date well completed firm name county well located

LANDOWNER: Dedrick Hart
Route 2
Bogue Chitto, Miss.
 (mailing address)

description of formations encountered	from	to
<u>Citronelle</u>	<u>1</u>	<u>53</u>

WELL LOCATION:
 sec. 7 T. 6 N. R. 8 E
5 miles S of Brookhaven
 (distance) (direction) (nearest town)

WELL PURPOSE: home
 (home, irrigation, municipal, industrial)

- WELL COMPLETION DATA:
- (1) diameter (inches) 4
 - (2) total depth (feet) 53
 - (3) static water level (feet) 34 below above top of ground.
 - (4) casing PVC 43
 (material) (depth)
4" if telescope see back.
 (size)
 - (5) screen 10' 43'
 (length) (depth to top)
.010 PVC
 (size) (material)
 - (6) pump 1/2 sub 8
 (HP) (yield gpm)
electricity
 (type power)
 - (7) electric log no
 (yes or no)
(organization running log)
 - (8) how well bottom plugged backwash valve

DEPT. OF NATURAL RESOURCES
 BUREAU OF LAND & WATER RESOURCES


OCT 23 1980

RECEIVED

DRILLERS REMARKS:

If well telescopes please sketch and show depths.

GROUND LEVEL

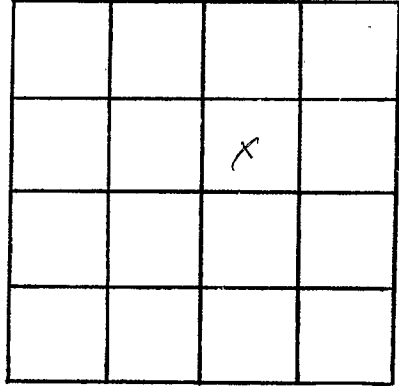

SECTION 7

Please indicate well location X.

ADDITIONAL INFORMATION

If more than one screen,
show locations of each on sketch.