

MISSISSIPPI DEPARTMENT OF NATURAL RESOURCES

Bureau of Land and Water Resources

Southport Mall

P.O. Box 10631

Jackson, Mississippi 39209

WATER WELL DRILLERS LOG

LINCOLN
M 2033
3-28-80

March 28 1980 *Reems Well Co Lincoln*
 date well completed firm name county well located

LANDOWNER:	description of formations encountered	from	to
<i>Glen Workman</i>			
<i>Rt 2 Bogie Chitto</i> (mailing address)	<i>2-3/4" gravel</i>	<i>15</i>	<i>36</i>
	<i>blue Chalk</i>	<i>36</i>	<i>160</i>
	<i>Coarse sand</i>	<i>160</i>	<i>193</i>

WELL LOCATION:
 sec. 6 T. 6 N R. 8 E
4 miles South of Brockham
 (distance) (direction) (nearest town)

WELL PURPOSE: Tractor
 (home, irrigation, municipal, industrial)

- WELL COMPLETION DATA:
- (1) diameter (inches) 4"
 - (2) total depth (feet) 193'
 - (3) static water level (feet) 52 below top of ground.
 - (4) casing plastic bottom
 (material) (depth)
 - (size) if telescope see back.
 - (5) screen 5' 187'
 (length) (depth to top)
 - 4" plastic
 (size) (material)
 - (6) pump 1/2 6
 (HP) (yield gpm)
 - elect
 (type power)
 - (7) electric log no
 (yes or no)

(organization running log)

(8) how well bottom plugged
Water plug

DRILLERS REMARKS:


DEPT. OF NATURAL RESOURCES
 BUREAU OF LAND & WATER RESOURCES

DEC 1 1980

RECEIVED

If well telescopes please sketch and show depths.

GROUND LEVEL

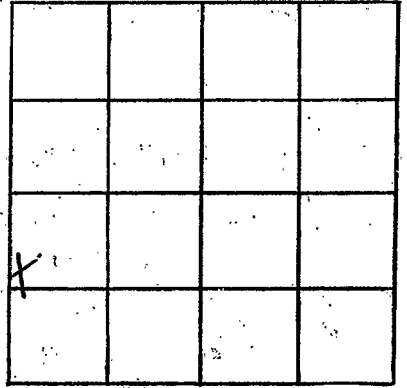

SECTION 6

Please indicate well location X.

ADDITIONAL INFORMATION

If more than one screen,
show locations of each on sketch.