

Lincoln
 M 2035
 2-10-81

MISSISSIPPI DEPARTMENT OF NATURAL RESOURCES
 Bureau of Land and Water Resources
 Southport Mall
 P.O. Box 10631
 Jackson, Mississippi 39209
 WATER WELL DRILLERS LOG

2/10 1981 Grenn Water Well Cont. Lincoln
 date well completed firm name county well located

LANDOWNER: Lamar Walls
 P.O. Box 47
 Brookhaven, Miss.
 (mailing address)

| description of formations encountered | from | to |
|---------------------------------------|------------|----|
| | Citronelle | 1 |


WELL LOCATION:
 sec. 14 T. 6 N. R. 8 E
 S W
 4 miles SE of Brookhaven
 (distance) (direction) (nearest town)

WELL PURPOSE: home
 (home, irrigation, municipal, industrial)

WELL COMPLETION DATA:
 (1) diameter (inches) 4
 (2) total depth (feet) 85
 (3) static water level (feet) 60 below above top of ground.
 (4) casing PVC 75'
 (material) (depth)
 4" if telescope see back.
 (size)
 (5) screen 10' 75'
 (length) (depth to top)
 .010 PVC
 (size) (material)
 (6) pump 1/2 sub 8
 (HP) (yield gpm)
 electricity
 (type power)
 (7) electric log no
 (yes or no)
 (organization running log)


(8) how well bottom plugged
 back wash valve

DRILLERS REMARKS:

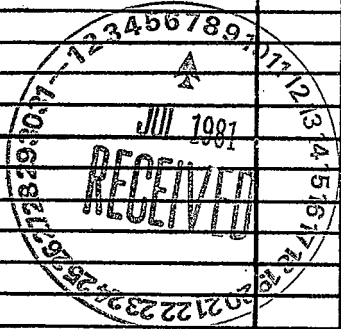

If well telescopes please sketch and show depths.

GROUND LEVEL

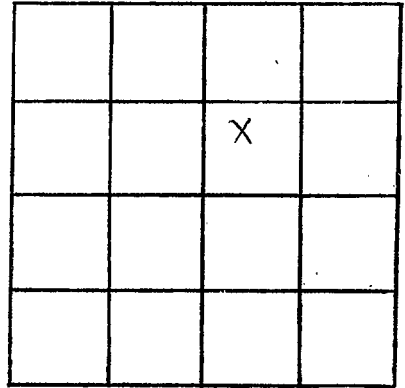

SECTION 14

Please indicate well location X.

ADDITIONAL INFORMATION

If more than one screen,
show locations of each on sketch.