

Lincoln
M 2036
8-9-81

MISSISSIPPI
BOARD OF WATER COMMISSIONERS
416 North State Street
Jackson, Mississippi 39201

WATER WELL DRILLERS LOG

8-9-81 date well completed 19 Burnfield Well Serv Lincoln firm name county well located

LANDOWNER: Billy Joe Brent

Bogue Chitt miss

| description of formations encountered | from | to |
|---------------------------------------|-----------|-----------|
| <u>SANDY Clay</u> | <u>0</u> | <u>19</u> |
| <u>SAND</u> | <u>19</u> | <u>31</u> |
| <u>GRAVEL</u> | <u>31</u> | <u>42</u> |
| <u>SANDY CLAY</u> | <u>42</u> | <u>43</u> |
| <u>CLAY</u> | <u>43</u> | <u>51</u> |
| <u>SAND</u> | <u>51</u> | <u>65</u> |
| <u>SAND + ROCK</u> | <u>65</u> | <u>79</u> |

(mailing address)

WELL LOCATION:

sec 32 T 6 N R 8 E
1 1/2 miles E of Bogue Chitt
(distance) (direction) (nearest town)

WELL PURPOSE: IRRIG
(home, irrigation, municipal, industrial)

WELL COMPLETION DATA:

- (1) diameter (inches) 4"
- (2) total depth (feet) 79
- (3) static water level (feet) 51 below above top of ground.
- (4) casing PVC 69
(material) (depth)
4" if telescope see back.
(size)
- (5) screen 10' 69'
(length) (depth to top)
4" PVC
(size) (material)
- (6) pump 1/2 Sub 10
(HP) (yield gpm).
Electric
(type power)
- (7) electric log no
(yes or no)

(organization running log)

(8) how well bottom plugged Sand Shank


DRILLERS REMARKS:

DEPT. OF NATURAL RESOURCES
BUREAU OF LAND & WATER RESOURCES

SEP 17 1981
RECEIVED

If well telescopes please sketch and show depths.

GROUND LEVEL

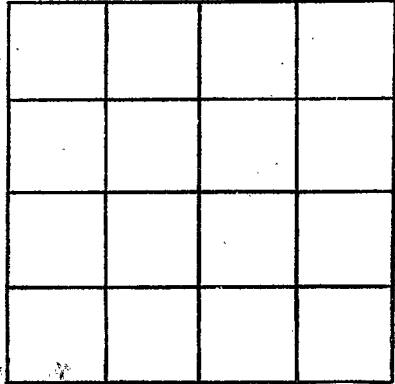

SECTION 92

Please indicate well location X.

ADDITIONAL INFORMATION

If more than one screen, show locations of each on sketch.