

MISSISSIPPI DEPARTMENT OF NATURAL RESOURCES

Bureau of Land and Water Resources

Southport Mall

P.O. Box 10631

Jackson, Mississippi 39209

WATER WELL DRILLERS LOG

| |
|----------------|
| <u>Lincoln</u> |
| <u>M 2037</u> |
| <u>9-8-81</u> |

Sept. 8 1981 Grenn Water Well Lincoln
 date well completed firm name county well located

| LANDOWNER: Gary Vining | description of formations encountered | from | to |
|---|---------------------------------------|------|----|
| Rt. 1, Box 128 Bogue Chitto, Ms. (mailing address) | | | |
| WELL LOCATION: sec <u>36</u> T <u>6</u> R <u>8</u> <u>4</u> miles E of Bogue Chitto (distance) (direction) (nearest town) | | | |
| WELL PURPOSE: home (home, irrigation, municipal, industrial) | | | |
| WELL COMPLETION DATA: (1) diameter (inches) <u>4</u> (2) total depth (feet) <u>100</u> (3) static water level (feet) <u>54</u> below above top of ground. (4) casing <u>PVC</u> <u>90'</u> <u>4"</u> (material) (depth) (size) if telescope see back. (5) screen <u>10'</u> <u>90'</u> <u>.010</u> <u>PVC</u> (length) (depth to top) (size) (material) (6) pump <u>did not install</u> (HP) (yield gpm) (type power) (7) electric log <u>no</u> (yes or no) (organization running log) (8) how well bottom plugged <u>Back wash valve</u> | | | |

DRILLERS REMARKS:


DEPT. OF NATURAL RESOURCES
BUREAU OF LAND & WATER RESOURCES

OCT 29 1981

RECEIVED

If well telescopes please sketch and show depths.

GROUND LEVEL

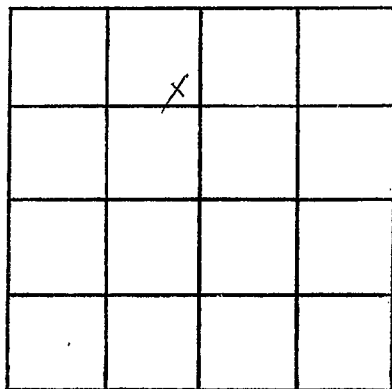

SECTION 36

Please indicate well location X.

ADDITIONAL INFORMATION

If more than one screen show locations of each on sketch.