

Lincoln  
M 2038  
10-19-81

MISSISSIPPI DEPARTMENT OF NATURAL RESOURCES  
Bureau of Land and Water Resources  
Southport Mall  
P.O. Box 10631  
Jackson, Mississippi 39209  
WATER WELL DRILLERS LOG

Oct. 19 1981 Grenn Water Well Cont. Lincoln  
date well completed firm name county well located


LANDOWNER: D.A. Lewis Route 2, Box 252 Bogue Chitto, Ms. (mailing address)	description of formations encountered Citronelle	from 1	to 120
<b>WELL LOCATION:</b>			
sec. 36 T 6 <sup>N</sup> <sub>S</sub> R 8 <sup>E</sup> <sub>W</sub>			
5 miles <sup>EW</sup> of Bogue Chitto (distance) (direction) (nearest town)			
<b>WELL PURPOSE:</b> home (home, irrigation, municipal, industrial)			
<b>WELL COMPLETION DATA:</b>			
(1) diameter (inches) 4			
(2) total depth (feet) 120			
(3) static water level (feet) 73 below above top of ground.			
(4) casing PVC 110' (material) (depth) 4" if telescope see back. (size)			
(5) screen 10' 110' (length) (depth to top) .010 PVC (size) (material)			
(6) pump 1/2 sub 8 (HP) (yield gpm) electricity (type power)			
(7) electric log no (yes or no) (organization running log)			
(8) how well bottom plugged back wash valve			
<b>DRILLERS REMARKS:</b>			

DEPT. OF NATURAL RESOURCES  
BUREAU OF LAND & WATER RESOURCES

DEC 11 1981  
RECEIVED

If well telescopes please sketch and show depths.

GROUND LEVEL

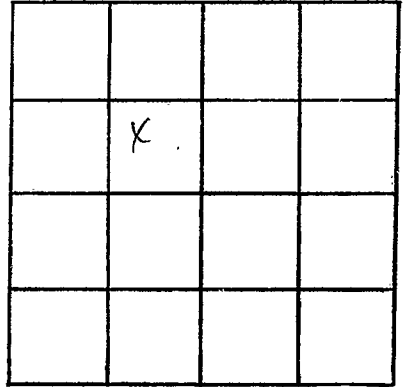

SECTION 36

Please indicate well location X.

ADDITIONAL INFORMATION

If more than one screen,  
show locations of each on sketch.