

MISSISSIPPI DEPARTMENT OF NATURAL RESOURCES

Bureau of Land and Water Resources

Southport Mall

P.O. Box 10631

Jackson, Mississippi 39209

WATER WELL DRILLERS LOG

Lincoln  
M  
2039

Sept 2 1981 Reynolds M & Son Lincoln  
 date well completed firm name county well located

LANDOWNER:	description of formations encountered	from	to
<u>Wayne Reynolds</u> <u>Rt Bogum Chitto</u> (mailing address)	<u>Red Clay</u> <u>Red Chalky at end</u> <u>sand &amp; gravel</u>	<u>0</u> <u>24</u> <u>76</u> <u>90</u>	<u>24</u> <u>76</u> <u>90</u>
<p>WELL LOCATION:</p> <p>sec <u>36</u> T <u>6</u> N R <u>8</u> E</p> <p><u>3</u> miles <u>ESE</u> of <u>Enterprise</u>                  (distance) (direction) (nearest town)</p>			
<p>WELL PURPOSE: <u>Trailer</u>                  (home, irrigation, municipal, industrial)</p>			
<p>WELL COMPLETION DATA:</p>			
<p>(1) diameter (inches) <u>4"</u></p>			
<p>(2) total depth (feet) <u>90'</u></p>			
<p>(3) static water level (feet) <u>65'</u> below above top of ground.</p>			
<p>(4) casing <u>Plastic, Cotton</u>                  (material) (depth)</p>			
<p><u>—</u> if telescope see back.                  (size)</p>			
<p>(5) screen <u>5'</u> <u>85'</u>                  (length) (depth to top)</p>			
<p><u>4"</u> <u>Plastic</u>                  (size) (material)</p>			
<p>(6) pump <u>1/2</u> <u>10</u>                  (HP) (yield gpm)</p>			
<p><u>electric</u>                  (type power)</p>			
<p>(7) electric log <u>no</u>                  (yes or no)</p>			
<p><u>—</u>                  (organization running log)</p>			
<p>(8) how well bottom plugged <u>Bochman Valve</u></p>			
<p>DRILLERS REMARKS:  <u>/</u></p>			


DEPT. OF NATURAL RESOURCES  
 BUREAU OF LAND & WATER RESOURCES

MAR 15 1982

RECEIVED

If well telescopes please  
sketch and show depths.

GROUND LEVEL

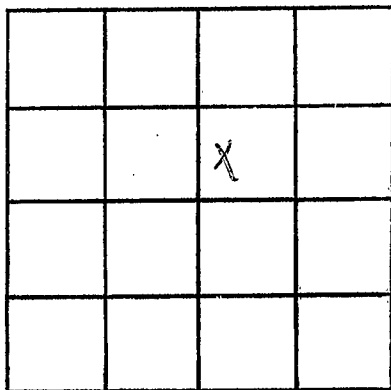

SECTION 36

Please indicate well location X.

ADDITIONAL INFORMATION

If more than one screen,  
show locations of each on sketch.