

MISSISSIPPI DEPARTMENT OF NATURAL RESOURCES

Bureau of Land and Water Resources

Southport Mall

P.O. Box 10631

Jackson, Mississippi 39209

WATER WELL DRILLERS LOG

Lincoln
M
2041

#1 Well

Griner Drilling Service, Inc.

Lincoln

3-1-82 date well completed

Griner Drilling Service, Inc. firm name

Lincoln county well located

LANDOWNER:	description of formations encountered	from	to
Shell Oil Company P.O. Box 61555 New Orleans, La 70160 (mailing address)	clay, sand	0	21
WELL LOCATION: N56°54'37.9"W sec. 31 T. 60N R. 8E NE/40	sand, gravel	21	84
No. 1 part of Bogue Chitto (direction) (nearest town)	chalk	84	231
WELL PURPOSE: oilfield supply (home, irrigation, municipal, industrial)	streaked	231	252
WELL COMPLETION DATA:	sand	252	294
(1) diameter (inches) 4"	sand, clay	294	350
(2) total depth (feet) 525'	chalk, 5' sand	350	392
(3) static water level (feet) 200' (below) above top of ground.	chalk, sand	392	413
(4) casing steel 525' (material) (depth)	chalk, sand	413	455
4" (size) if telescope see back.	sand	455	525
(5) screen 42' (length) 423' (depth to top)			
4" (size) perforated (material)			
(6) pump (HP) 50 (yield gpm)			
AC (type power)			
(7) electric log (yes or no)			
(organization running log)			
(8) how well bottom plugged orange peel			
DRILLERS REMARKS:			


DEPT. OF NATURAL RESOURCES
 BUREAU OF LAND & WATER RESOURCES

MAR 16 1982

RECEIVED

If well telescopes please sketch and show depths.

GROUND LEVEL

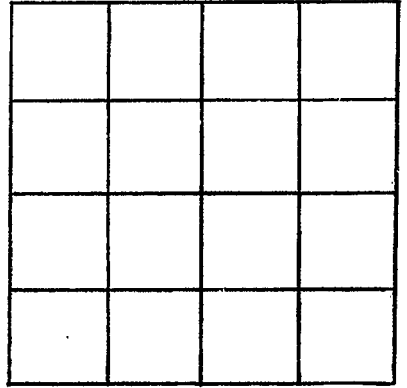

SECTION _____

Please indicate well location X.

ADDITIONAL INFORMATION

If more than one screen, show locations of each on sketch.