

Lincoln  
M  
2044

MISSISSIPPI DEPARTMENT OF NATURAL RESOURCES  
 Bureau of Land and Water Resources  
 Southport Mall  
 P.O. Box 10631  
 Jackson, Mississippi 39209  
**WATER WELL DRILLERS LOG**

June 8 19 82 Green Water Well Lincoln  
 date well completed firm name county well located

LANDOWNER: <u>Kenneth Thornhill</u> Rt. 1, Box 136 A	description of formations encountered	from	to
Brookhaven, Ms. (mailing address)	Citronelle	1	100
<b>WELL LOCATION:</b>			
sec. <u>36</u> T <u>6</u> N R <u>8</u> E S W <u>6</u> miles <u>East</u> of <u>Bogue Chitto</u> (distance) (direction) (nearest town)			
<b>WELL PURPOSE:</b> <u>home</u> (home, irrigation, municipal, industrial)			
<b>WELL COMPLETION DATA:</b>			
(1) diameter (inches) <u>4</u>			
(2) total depth (feet) <u>100</u>			
(3) static water level (feet) <u>58</u> below above top of ground.			
(4) casing <u>PVC</u> <u>90</u> (material) (depth) <u>4"</u> (size) if telescope see back.			
(5) screen <u>10'</u> <u>90'</u> (length) (depth to top) <u>.010</u> <u>PVC</u> (size) (material)			
(6) pump <u>did not install</u> (HP) (yield gpm)			
(type power)			
(7) electric log <u>no</u> (yes or no)			
(organization running log)			
(8) how well bottom plugged <u>back wash valve</u>			
DRILLERS REMARKS:			


MISSISSIPPI DEPARTMENT OF NATURAL RESOURCES  
 BUREAU OF LAND & WATER RESOURCES

AUG 20 1982

RECEIVED

If well telescopes please sketch and show depths.

GROUND LEVEL

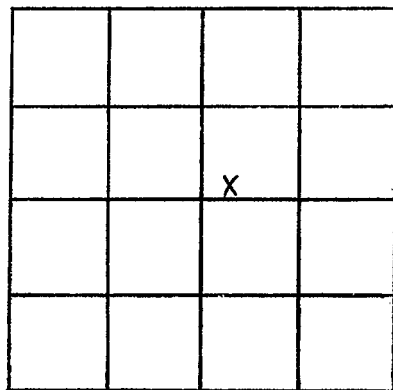

SECTION 36

Please indicate well location X.

ADDITIONAL INFORMATION

If more than one screen,  
show locations of each on sketch.