

MISSISSIPPI DEPARTMENT OF NATURAL RESOURCES
Bureau of Land and Water Resources
 Southport Mall
 P.O. Box 10631
 Jackson, Mississippi 39209
WATER WELL DRILLERS LOG

Lincoln
M 2049
3-12-83

Mar. 12 1983 Gretn Water Well Lincoln
 date well completed firm name county well located

LANDOWNER:	description of fomations encountered	from	to
Steve M. Beard Rt. 4, Box 281 Brookhaven, Ms. (mailing address)			
WELL LOCATION: sec. <u>22</u> T. <u>6</u> <u>N</u> R. <u>08</u> <u>E</u> S W <u>7</u> miles <u>SE</u> of <u>Brookhaven</u> (distance) (direction) (nearest town)			
WELL PURPOSE: <u>none</u> (home, irrigation, municipal, industrial)			
WELL COMPLETION DATA:			
(1) diameter (inches) <u>4</u>			
(2) total depth (feet) <u>52</u>			
(3) static water level (feet) <u>28</u> below above top of ground.			
(4) casing <u>PVC</u> <u>42'</u> (material) (depth) <u>4"</u> (size) if telescope see back.			
(5) screen <u>10'</u> <u>42'</u> (length) (depth to top) <u>.010</u> <u>PVC</u> (size) (material)			
(6) pump <u>1/2 sub 8</u> (HP) (yield gpm) <u>electricity</u> (type power)			
(7) electric log <u>no</u> (yes or no) <u>(organization running log)</u>			
(8) how well bottom plugged <u>back wash valve</u>			

DEPT. OF NATURAL RESOURCES
 BUREAU OF LAND & WATER RESOURCES


MAY 20 1983

RECEIVED

DRILLERS REMARKS: _____

If well telescopes please sketch and show depths.

GROUND LEVEL

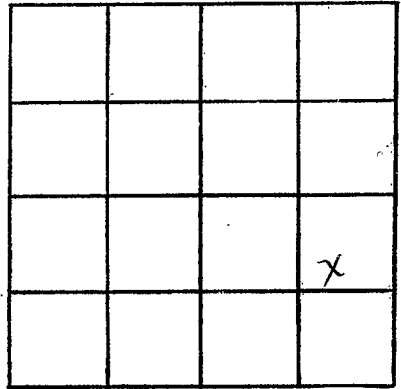

SECTION 22

Please indicate well location X.

ADDITIONAL INFORMATION

If more than one screen, show locations of each on sketch.