

Lincoln  
M  
2050

MISSISSIPPI DEPARTMENT OF NATURAL RESOURCES  
Bureau of Land and Water Resources  
Southport Mall  
P.O. Box 10631  
Jackson, Mississippi 39209  
WATER WELL DRILLERS LOG

April 11 1983 Reeves well serv. Lincoln  
date well completed firm name county well located

LANDOWNER:  
Mrs. Joy Gray  
Rt. Bayou Chitto  
(mailing address)

description of formations encountered	from	to
sandy clay	0	18
granite sand	18	47
sand rock	47	49
blue clay	49	215
fine sand	215	250
coarse sand	250	275

WELL LOCATION:  
sec. 20 T 6 N R 8 E  
2 miles north of B. Chitto  
(distance) (direction) (nearest town)

WELL PURPOSE: home  
(home, irrigation, municipal, industrial)

- WELL COMPLETION DATA:
- (1) diameter (inches) 4"
  - (2) total depth (feet) 275 ft
  - (3) static water level (feet) 90 ft below top of ground.
  - (4) casing plastic, 20' bottom  
(material) (depth)  
if telescope see back.
  - (5) screen 5' 270'  
(length) (depth to top)  
4" plastic  
(size) (material)
  - (6) pump Bu Others  
(HP) (yield gpm)  
Elect.  
(type power)
  - (7) electric log AD  
(yes or no)
  - (organization running log)
  - (8) how well bottom plugged back wash


DRILLERS REMARKS:

DEPT. OF NATURAL RESOURCES  
BUREAU OF LAND & WATER RESOURCES

JUN 17 1983  
RECEIVED

If well telescopes please sketch and show depths.

GROUND LEVEL

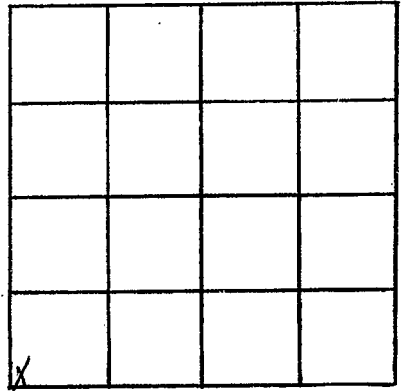

SECTION 30

Please indicate well location X.

ADDITIONAL INFORMATION

If more than one screen, show locations of each on sketch.