

Lincoln
M
2051

MISSISSIPPI DEPARTMENT OF NATURAL RESOURCES
 Bureau of Land and Water Resources
 Southport Mall
 P.O. Box 10631
 Jackson, Mississippi 39209
WATER WELL DRILLERS LOG

May 2 1983 Russell Lee Lincoln
 date well completed firm name county well located

LANDOWNER:
Billy Wilson
Rt Ruth
 (mailing address)

description of formations encountered	from	to
<u>Red sand clay</u>	<u>0</u>	<u>15</u>
<u>Red chert & sand</u>	<u>15</u>	<u>90</u>
<u>Red gravel & sand</u>	<u>90</u>	<u>92</u>

WELL LOCATION:
 sec 24 T 6 N R 8 E
7 miles DNW of Ruth
 (distance) (direction) (nearest town)

WELL PURPOSE: Trailer
 (home, irrigation, municipal, industrial)

- WELL COMPLETION DATA:
- (1) diameter (inches) 4"
 - (2) total depth (feet) 92
 - (3) static water level (feet) 60 below above top of ground
 - (4) casing plastic bottom (material) (depth)
 - (size) if telescope see back.
 - (5) screen 5' 87' (length) (depth to top)
 - 4" plastic (size) (material)
 - (6) pump 1/2 10 (HP) (yield gpm)
 - slit (type power)
 - (7) electric log no (yes or no)
 - (organization running log)

(8) how well bottom plugged rock wash

DRILLERS REMARKS:


DEPT. OF NATURAL RESOURCES
 BUREAU OF LAND & WATER RESOURCES

JUL 5 1983

RECEIVED

If well telescopes please sketch and show depths.

GROUND LEVEL

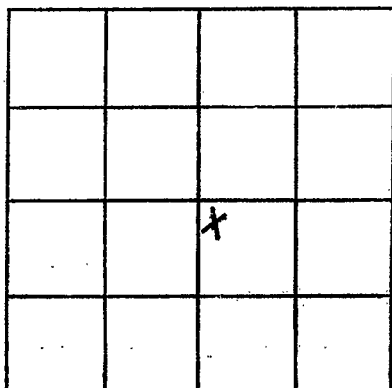

SECTION 24

Please indicate well location X.

ADDITIONAL INFORMATION

Multiple horizontal lines for additional information.

If more than one screen, show locations of each on sketch.