

Travis
M
2056

MISSISSIPPI DEPARTMENT OF NATURAL RESOURCES
Bureau of Land and Water Resources
Southport Mall
P.O. Box 10631
Jackson, Mississippi 39209
WATER WELL DRILLERS LOG

9-7 1983 Grenn Water Well Lincoln
date well completed firm name county well located

LANDOWNER: B. F. Wilson
Rt. 4, Box 306
Brookhaven, Ms.
(mailing address)

| description of formations encountered | from | to |
|---------------------------------------|----------|-----------|
| <u>Citronelle</u> | <u>1</u> | <u>57</u> |

WELL LOCATION:
sec 4 T 6 N R 8 E
S W
4 miles SE of Brookhaven
(distance) (direction) (nearest town)

WELL PURPOSE: home
(home, irrigation, municipal, industrial)

WELL COMPLETION DATA:

(1) diameter (inches) 4

(2) total depth (feet) 57

(3) static water level (feet) 35 below
top of ground. above

(4) casing PVC 47'
(material) (depth)
4"
(size) if telescope see back.

(5) screen 10' 47'
(length) (depth to top)
.010 PVC
(size) (material)

(6) pump 1/2 sub 8
(HP) (yield gpm)
electricity
(type power)

(7) electric log no
(yes or no)
(organization running log)

(8) how well bottom plugged back wash valve

DRILLERS REMARKS:


DEPT. OF NATURAL RESOURCES
BUREAU OF LAND & WATER RESOURCES

NOV 7 1983

RECEIVED

If well telescopes please sketch and show depths.

GROUND LEVEL

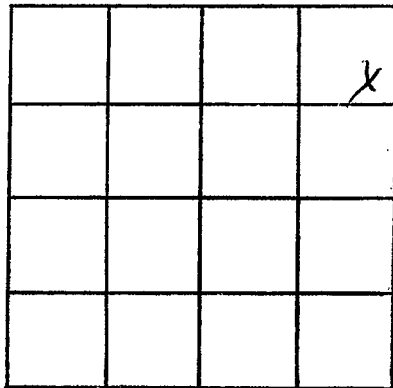

SECTION 4

Please indicate well location X.

ADDITIONAL INFORMATION

If more than one screen, show locations of each on sketch.