

Lincoln
M
207

MISSISSIPPI DEPARTMENT OF NATURAL RESOURCES
 Bureau of Land and Water Resources
 Southport Mall
 P.O. Box 10631
 Jackson, Mississippi 39209
WATER WELL DRILLERS LOG

9-7 1983 Grenn Water Well Lincoln
 date well completed firm name county well located

LANDOWNER: Luther Harper
Rt. 2, Bogue Chitto, Ms

description of formations encountered
Citronelle from 1 to 90

(mailing address)

WELL LOCATION:

sec 34 T 6 N R 8 E
 S W
4 miles East of Bogue Chitto
 (distance) (direction) (nearest town)

WELL PURPOSE: home
 (home, irrigation, municipal, industrial)

WELL COMPLETION DATA:

- (1) diameter (inches) 4
- (2) total depth (feet) 90
- (3) static water level (feet) 39 below above top of ground.
- (4) casing PVC 80'
 (material) (depth)
4" If telescope see back.
 (size)
- (5) screen 10' 80'
 (length) (depth to top)
.010 PVC
 (size) (material)
- (6) pump 1/2 sub 8
 (HP) (yield gpm)
electricity
 (type power)
- (7) electric log no
 (yes or no)
(organization running log)
- (8) how well bottom plugged
back wash valve

DRILLERS REMARKS:


DEPT. OF NATURAL RESOURCES
 BUREAU OF LAND & WATER RESOURCES

NOV -7 1983

RECEIVED

If well telescopes please sketch and show depths.

GROUND LEVEL

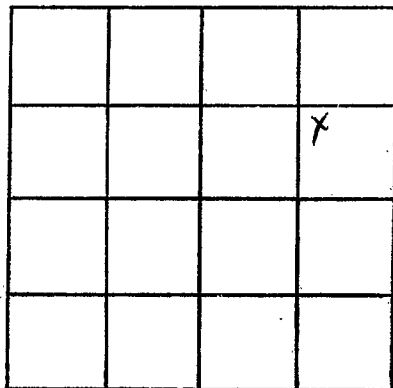

SECTION 34

Please indicate well location X.

ADDITIONAL INFORMATION

If more than one screen, show locations of each on sketch.