

Leslie  
M  
2059

MISSISSIPPI DEPARTMENT OF NATURAL RESOURCES  
Bureau of Land and Water Resources  
Southport Mall  
P.O. Box 10631  
Jackson, Mississippi 39209  
WATER WELL DRILLERS LOG

1-30-1984 Grenn Water Well Lincoln  
date well completed firm name county well located

LANDOWNER:  
Robert E. Douglas  
Route 4, Box 116  
Brookhaven, Ms.  
(mailing address)

description of formations encountered  
Citronelle  
from 1 to 103

WELL LOCATION:  
sec 10 T 6 N R 8 E  
S W  
5 miles SE of Brookhaven, Ms.  
(distance) (direction) (nearest town)

WELL PURPOSE: hom  
(home, irrigation, municipal, industrial)

- WELL COMPLETION DATA:
- (1) diameter (inches) 4
  - (2) total depth (feet) 103
  - (3) static water level (feet) 57 below above top of ground.
  - (4) casing PVC 83'  
(material) (depth)  
4"  
(size) if telescope see back.
  - (5) screen 20' 83'  
(length) (depth to top)  
.010 PVC  
(size) (material)
  - (6) pump 1 sub 20  
(HP) (yield gpm)  
electricity  
(type power)
  - (7) electric log no  
(yes or no)  
(organization running log)
  - (8) how well bottom plugged back wash valve


DRILLERS REMARKS:

DEPT. OF NATURAL RESOURCES  
BUREAU OF LAND & WATER RESOURCES

MAR - 8 1984  
RECEIVED

If well telescopes please sketch and show depths.

GROUND LEVEL

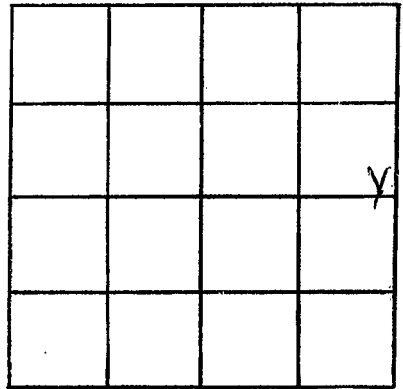

SECTION 10

Please indicate well location X.

ADDITIONAL INFORMATION

If more than one screen,  
show locations of each on sketch.