

MISSISSIPPI DEPARTMENT OF NATURAL RESOURCES

Bureau of Land and Water Resources

Southport Mall

P.O. Box 10631

Jackson, Mississippi 39209

WATER WELL DRILLERS LOG

Lincoln
M
2063

(2)

Dec-5 1983 Runer Well Ser Lincoln
 date well completed firm name county well located

LANDOWNER:
Morris Givens
at Ruth
 (mailing address)

description of formations encountered	from	to
<u>clay</u>	<u>0</u>	<u>16</u>
<u>red sand</u>	<u>16</u>	<u>40</u>
<u>red chalk</u>	<u>40</u>	<u>55</u>
<u>sand & gravel</u>	<u>55</u>	<u>77</u>

WELL LOCATION:
 sec 24 T-6 N R-8 E
2 miles east of Enterprise
 (distance) (direction) (nearest town)

WELL PURPOSE: drainage
 (home, irrigation, municipal, industrial)

- WELL COMPLETION DATA:
- (1) diameter (inches) 4"
 - (2) total depth (feet) 77
 - (3) static water level (feet) 40 below above top of ground.
 - (4) casing plastic bottom
 (material) (depth)
 - (size) if telescope see back.
 - (5) screen 10 , 67'
 (length) (depth to top)
 - 4" , plastic
 (size) (material)
 - (6) pump 1/2 hp 20
 (HP) (yield gpm)
 - electric
 (type power)
 - (7) electric log no
 (yes or no)
 - (organization running log)
 - (8) how well bottom plugged
rock wash

DRILLERS REMARKS:


DEPT. OF NATURAL RESOURCES
 BUREAU OF LAND & WATER RESOURCES

APR 30 1984

RECEIVED

If well telescopes please sketch and show depths.

GROUND LEVEL

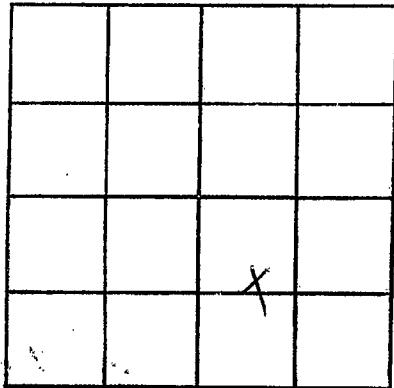

SECTION 24

Please indicate well location X.

ADDITIONAL INFORMATION

If more than one screen, show locations of each on sketch.