

LINCOLN  
M 2067

MISSISSIPPI DEPARTMENT OF NATURAL RESOURCES  
Bureau of Land and Water Resources  
Southport Mall  
P.O. Box 10631  
Jackson, Mississippi 39209  
WATER WELL DRILLERS LOG

5-25  
date well completed

1984  
Grenn Water Well  
firm name

Lincoln  
county well located

LANDOWNER: Kermit Conn  
Rt. 2, Box 172  
Bogue Chitto, Ms.  
(mailing address)

description of formations encountered	from	to
Citronelle	1	83

WELL LOCATION:  
sec. 7 T 6 N R 8 E  
S W  
5 miles South of Brookhaven  
(distance) (direction) (nearest town)

WELL PURPOSE: home  
(home, irrigation, municipal, industrial)

- WELL COMPLETION DATA:
- (1) diameter (inches) 4
  - (2) total depth (feet) 83
  - (3) static water level (feet) 59 below top of ground.
  - (4) casing PVC 73  
(material) (depth)  
4" if telescope see back.  
(size)
  - (5) screen 10' 73'  
(length) (depth to top)  
.010 PVC  
(size) (material)
  - (6) pump 1/2 sub 8  
(HP) (yield gpm)  
electricity  
(type power)
  - (7) electric log no  
(yes or no)  
(organization running log)
  - (8) how well bottom plugged back wash valve

DEPT. OF NATURAL RESOURCES  
BUREAU OF LAND & WATER RESOURCES


JUL 24 1984

RECEIVED

DRILLERS REMARKS:

If well telescopes please sketch and show depths.

GROUND LEVEL

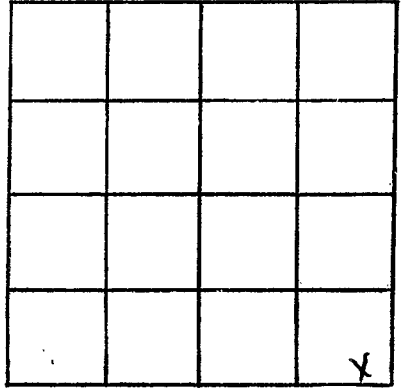

SECTION 7

Please indicate well location X.

ADDITIONAL INFORMATION

If more than one screen,  
show locations of each on sketch.