

Lincoln
M
2068

MISSISSIPPI DEPARTMENT OF NATURAL RESOURCES
 Bureau of Land and Water Resources
 Southport Mall
 P.O. Box 10631
 Jackson, Mississippi 39209
WATER WELL DRILLERS LOG

July 7 1984 Grenn Water Well Lincoln
 date well completed firm name county well located

LANDOWNER: <u>David Thompson</u>	description of formations encountered	from	to
<u>Rt. 2</u>			
<u>Bogue Chitto, Ms.</u>	<u>sand</u>	<u>20</u>	<u>35</u>
<u>(mailing address)</u>	<u>white clay</u>	<u>35</u>	<u>55</u>
<u>WELL LOCATION:</u>	<u>blue clay</u>	<u>55</u>	<u>190</u>
<u>sec. 15 T 6 N R 8 E</u>	<u>sand</u>	<u>190</u>	<u>218</u>
<u>4 miles NE of Bogue Chitto</u>			
<u>(distance) (direction) (nearest town)</u>			
<u>WELL PURPOSE: home</u>			
<u>(home, irrigation, municipal, industrial)</u>			
<u>WELL COMPLETION DATA:</u>			
(1) diameter (inches) <u>4</u>			
(2) total depth (feet) <u>218</u>			
(3) static water level (feet) <u>40</u> below above top of ground.			
(4) casing <u>PVC</u> <u>208'</u>			
<u>(material) (depth)</u>			
<u>4"</u> if telescope see back.			
<u>(size)</u>			
(5) screen <u>10'</u> <u>208'</u>			
<u>(length) (depth to top)</u>			
<u>.010</u> <u>PVC</u>			
<u>(size) (material)</u>			
(6) pump <u>1/2 sub</u> <u>8</u>			
<u>(HP) (yield gpm)</u>			
<u>electricity</u>			
<u>(type power)</u>			
(7) electric log <u>no</u>			
<u>(yes or no)</u>			
<u>(organization running log)</u>			
(8) how well bottom plugged <u>back wash valve</u>			

DEPT. OF NATURAL RESOURCES
 BUREAU OF LAND & WATER RESOURCES


SEP 16 1984

RECEIVED

DRILLERS REMARKS:

If well telescopes please sketch and show depths.

GROUND LEVEL

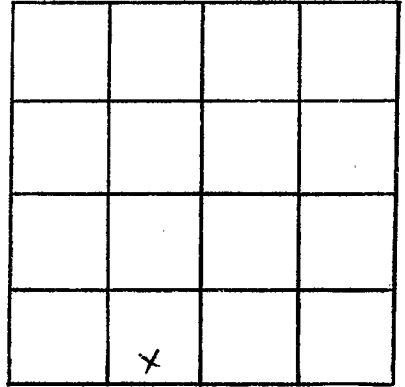

SECTION 15

Please indicate well location X.

ADDITIONAL INFORMATION

If more than one screen,
show locations of each on sketch.