

MISSISSIPPI DEPARTMENT OF NATURAL RESOURCES

Bureau of Land and Water Resources

Southport Mall

P.O. Box 10631

Jackson, Mississippi 39209

WATER WELL DRILLERS LOG

LINCOLN
M 2070

Oct. 14 19 84 Grenn Water Well Lincoln
date well completed firm name county well located

LANDOWNER: George Coghlan Rt. 4, Box 302B	description of formations encountered Citronelle	from 1	to 86
Brookhaven, Ms. (mailing address)			
WELL LOCATION: sec. 3 T 6 N R 8 E S W 5 miles SE of Brookhaven (distance) (direction) (nearest town)			
WELL PURPOSE: home (home, irrigation, municipal, industrial)			
WELL COMPLETION DATA:			
(1) diameter (inches) 4			
(2) total depth (feet) 86			
(3) static water level (feet) 53 below above top of ground.			
(4) casing PVC 66 (material) (depth) 4" (size) if telescope see back.			
(5) screen 20' 66' (length) (depth to top)			
.010 PVC (size) (material)			
(6) pump did not install (HP) (yield gpm) (type power)			
(7) electric log no (yes or no) (organization running log)			
(8) how well bottom plugged back wash valve			
DRILLERS REMARKS:			


RECEIVED

NOV - 4 1985

Department of Natural Resources
Bureau of Land & Water Resources

If well telescopes please sketch and show depths.

GROUND LEVEL

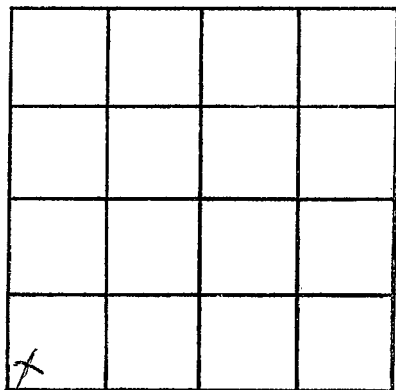

SECTION 3

Please indicate well location X.

ADDITIONAL INFORMATION

If more than one screen,
show locations of each on sketch.