

MISSISSIPPI DEPARTMENT OF NATURAL RESOURCES

Bureau of Land and Water Resources

Southport Mall

P.O. Box 10631

Jackson, Mississippi 39209

WATER WELL DRILLERS LOG

LINCOLN
M 2071

10/25 1986 Easley Plumbing Co @ Easley Drilling Linesln
date well completed firm name county well located

LANDOWNER: Paul Reid
RT 4 Box 128
Brookhaven, MS 39601
(mailing address)

description of formations encountered	from	to
	Clay	0
Fine Sand	150	165
Clay	165	210
Sand	210	240

WELL LOCATION:
sec. 1 T 6 N R 8 E
6 miles SE of Brookhaven
(distance) (direction) (nearest town)

WELL PURPOSE: Home
(home, irrigation, municipal, industrial)

WELL COMPLETION DATA:

- (1) diameter (inches) 4"
- (2) total depth (feet) 240'
- (3) static water level (feet) 24' below top of ground.
- (4) casing PVC, 230' (depth), 4" (size) if telescope see back.
- (5) screen 10' (length), 230' (depth to top), 4" (size), PVC (material)
- (6) pump 1 (HP), 10 (yield gpm), electricity (type power)
- (7) electric log No (yes or no)

RECEIVED

DEC 21 1986

(organization running log)


(8) how well bottom plugged, Backwash Valve

DRILLERS REMARKS:

Department of Natural Resources
Bureau of Land & Water Resources

If well telescopes please sketch and show depths.

GROUND LEVEL

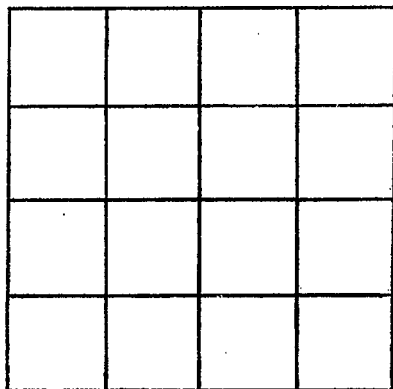

SECTION _____

Please indicate well location X.

ADDITIONAL INFORMATION

If more than one screen,
show locations of each on sketch.