

MISSISSIPPI DEPARTMENT OF NATURAL RESOURCES

Bureau of Land and Water Resources

P.O. Box 10631

Jackson, Mississippi 39209

WATER WELL DRILLERS LOG

COUNTY WELL LOCATED <i>Lincoln</i>	
WELL NUMBER <i>M 2077</i>	CODED
DATE WELL COMPLETED <i>1-4-88</i>	

PERMIT NUMBER
NAME OF DRILLING FIRM <i>Green Water Well & Supply Inc.</i>

NAME & MAILING ADDRESS OF LANDOWNER <i>Scotty Prather</i> <i>Route 2</i> <i>Boques Church, Miss.</i>			
WELL LOCATION: SEC	TOWNSHIP	RANGE	
<i>7</i>	<i>6 S</i>	<i>8 W</i>	
DISTANCE	DIRECTION	NEAREST TOWN	
<i>5</i> Miles	<i>S</i>	<i>Brookhaven</i>	
OTHER LANDMARK			
WELL PURPOSE: Home, Irrigation, Municipal, Industrial, Fish Pond, etc. <i>Home</i>			

PUMP DATA			
PUMP TYPE (Circle One): <input checked="" type="radio"/> Submersible, <input type="radio"/> Turbine, <input type="radio"/> Jet <input type="radio"/> Flowing Well, Other (Describe) _____			
POWER TYPE (Circle One): <input checked="" type="radio"/> Electric, <input type="radio"/> Tractor, <input type="radio"/> Diesel, <input type="radio"/> Gasoline, <input type="radio"/> Butane, Other (Describe) _____			
Pump Capacity (GPM)	No. of Stages	Setting Depth	
<i>10</i>	<i>10</i>	<i>68</i>	FT.
PUMP TEST			
Well yielded <i>10</i> GPM with a drawdown of <i>0</i> ft. after <i>10 min</i> hours of pumping			

WELL DATA			
Well Depth	Casing Diameter (In.)	Casing Length (Ft.)	
<i>78</i>	<i>4</i>	<i>68</i>	
Type of Casing	Hole Depth	Depth to Static Water Level	
<i>PVC</i>	<i>85</i>	<i>48</i>	
TYPE OF COMPLETION: (Circle One or More): <input checked="" type="checkbox"/> Gravel Packed, <input type="checkbox"/> Underreamed, <input type="checkbox"/> Telescoped, <input type="checkbox"/> Natural Development, <input type="checkbox"/> Open Hole, <input type="checkbox"/> Other (Describe) _____			
Top of Lap Pipe or Reduction in Casing			
FEET	IF TELESCOPED OR MORE THAN ONE SCREEN: USE BACK PAGE		

LOG DATA	
TYPE OF LOG RUN (Circle One): <input checked="" type="radio"/> No Log Run, <input type="radio"/> Electric, <input type="radio"/> Gamma Ray, <input type="radio"/> Density, <input type="radio"/> Sonic, <input type="radio"/> Neutron, Other (Describe) _____	
Name of Organization Running Log	

SCREEN DATA		
Diameter - Inches	Length - Feet	Slot Size - Inches
<i>4</i>	<i>10</i>	<i>10 10</i>
Screen Type	Depth to Bottom - Feet	
<i>PVC</i>	<i>78</i>	

GEOLOGIC DATA (Office Use Only)			
Surface Elev.	Geologic Unit	Unit Thickness	Depth to Top
Subs. SWL	Date	Analysis	Aquifer Test


Driller's Remarks	

DESCRIPTION OF FORMATIONS ENCOUNTERED	FROM	TO	FORMATIONS (Continued)	FROM	TO
<i>Citronelle Clay</i>	<i>1</i>	<i>78</i>	<div style="border: 2px solid black; padding: 5px; display: inline-block;"> RECEIVED APR 25 1988 Department of Natural Resources Bureau of Land & Water Resources </div>		
	<i>78</i>	<i>85</i>			

IF MORE SPACE IS NEEDED, USE BACK

If well telescopes please sketch and show depths.

GROUND LEVEL

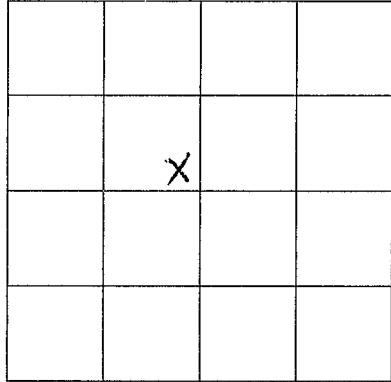

SECTION 4

Please indicate well location X.

ADDITIONAL INFORMATION

If more than one screen,
show location of each on sketch.