

MISSISSIPPI DEPARTMENT OF NATURAL RESOURCES

Bureau of Land and Water Resources

P.O. Box 10631

Jackson, Mississippi 39209

WATER WELL DRILLERS LOG

COUNTY WELL LOCATED LINCOLN	
WELL NUMBER 102751	CODED #1
M 2090	
DATE WELL COMPLETED 4-06-92	

PERMIT NUMBER 510
NAME OF DRILLING FIRM EASLEY WATER Well
BROOKHAVEN, MS 39601

NAME & MAILING ADDRESS OF LANDOWNER Tony Rando			
WELL LOCATION:	SEC	TOWNSHIP	RANGE
	28	6	N 8 W
DISTANCE	DIRECTION	NEAREST TOWN	
3 Miles	South	ENTERPRISE	
OTHER LANDMARK			
WELL PURPOSE: Home, Irrigation, Municipal, Industrial, Fish Pond, etc. Home - CHICKEN HOUSE			

PUMP DATA		
PUMP TYPE (Circle One): <input checked="" type="radio"/> Submersible, <input type="radio"/> Turbine, <input type="radio"/> Jet <input type="radio"/> Flowing Well, Other (Describe) LHP		
POWER TYPE (Circle One): <input checked="" type="radio"/> Electric, <input type="radio"/> Tractor, <input type="radio"/> Diesel, <input type="radio"/> Gasoline, <input type="radio"/> Butane, Other (Describe)		
Pump Capacity (GPM)	No. of Stages	Setting Depth
	15	FT.
PUMP TEST		
Well yielded _____ GPM with a drawdown of _____ ft. after _____ hours of pumping		

WELL DATA		
Well Depth 123'	Casing Diameter (In.) 4"	Casing Length (Ft.) 103'
Type of Casing PVC	Hole Depth 123'	Depth to Static Water Level
TYPE OF COMPLETION: (Circle One or More): <input checked="" type="radio"/> Gravel Packed, <input type="radio"/> Underreamed, <input type="radio"/> Telescoped, <input checked="" type="radio"/> Natural Development, <input type="radio"/> Open Hole, <input type="radio"/> Other (Describe)		
Top of Lap Pipe or Reduction in Casing		
FEET IF TELESCOPED OR MORE THAN ONE SCREEN: USE BACK PAGE		

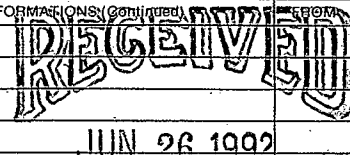
LOG DATA	
TYPE OF LOG RUN (Circle One): <input type="radio"/> No Log Run, <input type="radio"/> Electric, <input type="radio"/> Gamma Ray, <input type="radio"/> Density, <input type="radio"/> Sonic, <input type="radio"/> Neutron, Other (Describe)	
Name of Organization Running Log	

SCREEN DATA		
Diameter - Inches 4"	Length - Feet 20'	Slot Size - Inches 010
Screen Type PVC	Depth to Bottom - Feet 123'	

GEOLOGIC DATA (Office Use Only)			
Surface Elev.	Geologic Unit	Unit Thickness	Depth to Top
Subs. SWL	Date	Analysis	Aquifer Test

Driller's Remarks

DESCRIPTION OF FORMATIONS ENCOUNTERED	FROM	TO
Clay	0	20'
SAND	20'	60'
SAND & Gravel	60'	100'
COARSE SAND	100'	123'


Dept. of Environmental Quality Bureau of Land & Water Resources
IF MORE SPACE IS NEEDED, USE BACK

