

MISSISSIPPI DEPARTMENT OF ENVIRONMENTAL QUALITY
Bureau of Land and Water Resources

P. O. Box 10631
Jackson, MS 39289-0631
WATER WELL DRILLERS LOG

COUNTY WELL LOCATED <i>Lencoln</i>	
WELL NUMBER <i>M 2093</i>	CODED
DATE WELL COMPLETED <i>5-22-92</i>	

PERMIT NUMBER
NAME OF DRILLING FIRM <i>Brown Water Well + Supply Inc.</i>

NAME & MAILING ADDRESS OF LANDOWNER <i>Tony Wallace</i>		
<i>Rt 4 Box 300C</i>		
<i>Brookhaven MS</i>		
WELL LOCATION: SEC	TOWNSHIP	RANGE
<i>3</i>	<i>6</i>	<i>8</i>
		<i>W</i>
DISTANCE	DIRECTION	NEAREST TOWN
<i>6</i> Miles	<i>S</i>	<i>Brookhaven</i>
OTHER LANDMARK		
WELL PURPOSE: <input checked="" type="checkbox"/> Home Irrigation, Municipal, Industrial, Fish Pond, etc.		

PUMP DATA		
PUMP TYPE (Circle One): <input checked="" type="checkbox"/> Submersible, Turbine, Jet, Flowing Well, Other (Describe) _____		
POWER TYPE (Circle One): <input checked="" type="checkbox"/> Electric, Tractor, Diesel, Gasoline, Butane, Other (Describe) _____ H/P <i>1/2</i>		
Pump Capacity (GPM) <i>10</i>	No. of Stages <i>9</i>	Setting Depth <i>80</i> FT.
PUMP TEST		
Well yielded <i>10</i> GPM with a drawdown of <i>2</i> ft. after <i>1</i> hours of pumping		

WELL DATA		
Well Depth <i>110</i>	Casing Diameter (In.) <i>4</i>	Casing Length (Ft.) <i>100</i>
Type of Casing <i>PVC</i>	Hole Depth <i>115</i>	Depth to Static Water Level <i>55</i>
TYPE OF COMPLETION: (Circle One or More): <input checked="" type="checkbox"/> Gravel Packed, Underreamed, Telescoped, Natural Development, Open Hole, Other (Describe) _____		
Top of Lap Pipe or Reduction in Casing		
FEET <input type="checkbox"/> IF TELESCOPED OR MORE THAN ONE SCREEN: USE BACK PAGE		

LOG DATA	
TYPE OF LOG RUN (Circle One): Electric, Gamma Ray, Density, Sonic, <input checked="" type="checkbox"/> Neutron, Other (Describe) _____	
Name of Organization Running Log	

SCREEN DATA		
Diameter - Inches <i>4</i>	Length - Feet <i>10</i>	Slot Size - Inches <i>.010</i>
Screen Type <i>PVC</i>	Depth to Bottom - Feet <i>110</i>	


GEOLOGIC DATA (Office Use Only)			
Surface Elev.	Geologic Unit	Unit Thickness	Depth to Top
Subs. SWL	Date	Analysis	Aquifer Test

Driller's Remarks

DESCRIPTION OF FORMATIONS ENCOUNTERED	FROM	TO	FORMATIONS (Continued)	FROM	TO
<i>Clay</i>	<i>0</i>	<i>20</i>	RESERVED JUN 26 1992		
<i>Red Sandy Clay</i>	<i>20</i>	<i>72</i>			
<i>Gravel</i>	<i>72</i>	<i>84</i>			
<i>Clay</i>	<i>84</i>	<i>88</i>			
<i>Sand</i>	<i>88</i>	<i>100</i>			
<i>Clay</i>	<i>110</i>	<i>115</i>			
			Dept. of Environmental Quality Bureau of Land & Water Resources		
IF MORE SPACE IS NEEDED, USE BACK					

If well telescopes please
sketch and show depths.

GROUND LEVEL

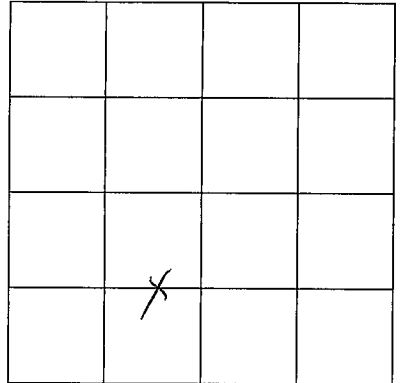

SECTION 3

Please indicate well location X.

ADDITIONAL INFORMATION

If more than one screen,
show location of each on sketch.