

MISSISSIPPI DEPARTMENT OF ENVIRONMENTAL QUALITY

Office of Land and Water Resources

P. O. Box 10631
Jackson, MS 39289-0631

WATER WELL DRILLERS LOG

COUNTY WELL LOCATED

L. H. COLH

WELL NUMBER

M 2095

CODED

PERMIT NUMBER

NAME OF DRILLING FIRM

Fitzgerald Well Serv

DATE WELL COMPLETED

June 2 94

NAME & MAILING ADDRESS OF LANDOWNER

B. L. VANCE

R. B. Boye ditto m.

WELL LOCATION:

SEC 7 TOWNSHIP 6 N RANGE 8 E W

DISTANCE

DIRECTION

NEAREST TOWN

8 Miles

S

of Brookhaven

OTHER LANDMARK

WELL PURPOSE: Home, Irrigation, Municipal, Industrial, Fish Pond, etc.

Home

PUMP DATA

PUMP TYPE (Circle One):

Submersible, Turbine, Jet, Flowing Well, Other (Describe) _____

POWER TYPE (Circle One):

Electric, Tractor, Diesel, Gasoline, Butane, Other (Describe) _____ H/P 3/4

Pump Capacity (GPM)

10

No. of Stages

12

Setting Depth

120 FT.

PUMP TEST

Well yielded 20 GPM with

a drawdown of 3 ft.

after 2 hours of pumping

WELL DATA

Well Depth

171

Casing Diameter (In.)

4

Casing Length (Ft.)

161

Type of Casing

PVC

Hole Depth

171

Depth to Static Water Level

75

TYPE OF COMPLETION: (Circle One or More):

Gravel Packed, Underreamed, Telescoped, Natural Development, Open Hole, Other (Describe) _____

WELL GROUTED TO A DEPTH OF 10 FEET

Type Grout (circle one): Cement, Bentonite, or Mix

LOG DATA

TYPE OF LOG RUN (Circle One):

No Log Run, Electric, Gamma Ray, Density, Sonic, Neutron, Other (Describe) _____

Name of Organization Running Log

GEOLOGIC DATA (Office Use Only)

Surface Elev.	Geologic Unit	Unit Thickness	Depth to Top
Subs. SWL	Date	Analysis	Aquifer Test

SCREEN DATA

Diameter - Inches

4

Length - Feet

10

Slot Size - Inches

.010

Screen Type

PVC

Depth to Bottom - Feet

171

Driller's Remarks

RECEIVED
Top of Lap. Pipe or Reduction in Casing
FEET IF TELESCOPED OR MORE THAN ONE SCREEN: USE BACK PAGE

DESCRIPTION OF FORMATIONS ENCOUNTERED

FROM

TO

FORMATIONS ENCOUNTERED

FROM

TO

Red Clay 0 20
Red Silty 20 45
Blue Chalk 45 157
Coarse Sand 157 171


JUL 21 1994

Dept. of Environmental Quality
Office of Land & Water Resources

IF MORE SPACE IS NEEDED, USE BACK

If well telescopes please
sketch and show depths.

GROUND LEVEL

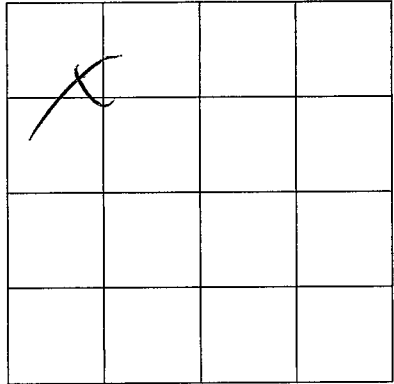

SECTION 7

Please indicate well location X.

ADDITIONAL INFORMATION

If more than one screen,
show location of each on sketch.