

#2

MISSISSIPPI DEPARTMENT OF ENVIRONMENTAL QUALITY

COUNTY WELL LOCATED
Lumbard

WELL NUMBER
M 2113

CODED

DATE WELL COMPLETED
3-6-98

Green Water Well & Supply
1318 Pricedale Dr. SE
Bogue Chitto, MS 39629

Office of Land and Water Resources

P. O. Box 10631
Jackson, MS 39289-0631

WATER WELL DRILLERS LOG

NAME & MAILING ADDRESS OF LANDOWNER
D D McCullough

960 Mt. Olive Rd

Bogue Chitto MS 39629

WELL LOCATION: SEC TOWNSHIP RANGE
17 6 N 8 W

DISTANCE DIRECTION NEAREST TOWN
5 Miles S of Brookhaven

OTHER LANDMARK
Poultry Farm

WELL PURPOSE: Home, Irrigation, Municipal, Industrial, Fish Pond, etc.
Poultry Farm

PUMP DATA

PUMP TYPE (Circle One):
 Submersible, Turbine, Jet, Flowing Well,
Other (Describe) _____

POWER TYPE (Circle One):
 Electric, Tractor, Diesel, Gasoline, Butane,
Other (Describe) _____

Pump Capacity (GPM) No. of Stages Setting Depth
25 9 45' FT.

PUMP TEST

Well yielded *30* GPM with
a drawdown of *0* ft.
after *1* hours of pumping

WELL DATA

Well Depth <i>50'</i>	Casing Diameter (In.) <i>4"</i>	Casing Length (Ft.) <i>30'</i>
Type of Casing <i>PVC</i>	Hole Depth <i>60'</i>	Depth to Static Water Level <i>14'</i>

LOG DATA

TYPE OF LOG RUN (Circle One): No Log Run
Electric, Gamma Ray, Density, Sonic, Neutron,
Other (Describe) _____

Name of Organization Running Log

TYPE OF COMPLETION: (Circle One or More):
 Gravel Packed, Underreamed, Telescoped,
Natural Development, Open Hole, Other
(Describe) _____

WELL GROUTED TO A DEPTH OF *10* FEET
Type Grout (circle one): Cement, Bentonite, or Mix

SCREEN DATA

Diameter - Inches <i>4"</i>	Length - Feet <i>20'</i>	Slot Size - Inches <i>10/10</i>
Screen Type <i>PVK</i>	Depth to Bottom - Feet <i>50'</i>	

GEOLOGIC DATA (Office Use Only)

Surface Elev.	Geologic Unit	Unit Thickness	Depth to Top
Subs. SWL	Date	Analysis	Aquifer Test

Driller's Remarks

Top of Lap Pipe or Reduction in Casing
FEET IF TELESCOPED OR MORE THAN ONE SCREEN: USE BACK PAGE

DESCRIPTION OF FORMATIONS ENCOUNTERED	FROM	TO
<i>Red Clay</i>	<i>0</i>	<i>7</i>
<i>White Clay</i>	<i>7</i>	<i>18</i>
<i>Sand/Gravel</i>	<i>18</i>	<i>50</i>
<i>White Clay</i>	<i>50</i>	<i>60</i>

FORMATIONS ENCOUNTERED FROM TO

REGISTERED

JAN 25 1999

Dept of Environmental Quality
Office of Land & Water Resources

IF MORE SPACE IS NEEDED, USE BACK

If well telescopes please
sketch and show depths.


GROUND LEVEL

	X		

SECTION 17

Please indicate well location X.

ADDITIONAL INFORMATION

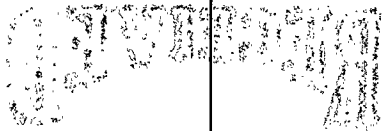

If more than one screen,
show location of each on sketch.