

MISSISSIPPI DEPARTMENT OF ENVIRONMENTAL QUALITY
Office of Land and Water Resources

P. O. Box 10631
Jackson, MS 39289-0631
WATER WELL DRILLERS LOG

COUNTY WELL LOCATED
Lincoln

WELL NUMBER
M-2146

DATE WELL COMPLETED
6/28/02

PERMIT NUMBER

NAME OF DRILLING FIRM
Green Water Well
a Supply Inc.

NAME & MAILING ADDRESS OF LANDOWNER
Danny Cody

1835 Topisaw Dr., Bogue Chitto

Latitude:

Longitude:

WELL LOCATION. SEC TOWNSHIP RANGE
26 6 N 8 E

DISTANCE DIRECTION NEAREST TOWN
7 Miles 6 of Bogue Chitto

OTHER LANDMARK

WELL PURPOSE: Farm, Irrigation, Municipal, Industrial, Fish Pond, etc.

PUMP DATA

PUMP TYPE (Circle One):
Submersible, Turbine, Jet, Flowing Well,
Other (Describe)

POWER TYPE (Circle One):
Electric, Tractor, Diesel, Gasoline, Butane,
Other (Describe). H/P 1/2

DESCRIPTION OF FORMATIONS ENCOUNTERED	FROM	TO
<u>red clay</u>	<u>0</u>	<u>45</u>
<u>sand & gravel</u>	<u>45</u>	<u>108</u>
<u>yellow clay</u>	<u>108</u>	<u>109</u>

RECEIVED

III 25 2002

BY: OLWR

Top of Lap Pipe or Reduction in Casing

FEET IF TELESCOPED OR MORE THAN ONE SCREEN: USE BACK PAGE

WELL DATA

Well Depth <u>104'</u>	Casing Diameter (In.) <u>4"</u>	Casing Length (Ft.) <u>94'</u>
Type of Casing <u>PVC</u>	Hole Depth <u>109'</u>	Depth to Static Water Level <u>52'</u>

TYPE OF COMPLETION: (Circle One or More):
 Gravel Packed, Underreamed, Telescoped,
 Natural Development, Open Hole, Other
(Describe)

WELL GROUTED TO A DEPTH OF _____ FEET
Type Grout (circle one): Cement, Bentonite, or Mix

SCREEN DATA

Diameter - Inches <u>4"</u>	Length - Feet <u>10'</u>	Slot Size - Inches <u>.010</u>
Screen Type <u>PVC</u>	Depth to Bottom - Feet <u>104'</u>	

I certify that the well was drilled, constructed and completed in accordance with all applicable Requirements of the Mississippi Department of Environmental Quality and/or the Mississippi Department of Health regulations and state laws.


Brian McLeod 0-664
Signature of Licensed Driller and License No.

6/28/02
Date

Additional Information Required On Back

If well telescopes please sketch and show depths.

GROUND LEVEL

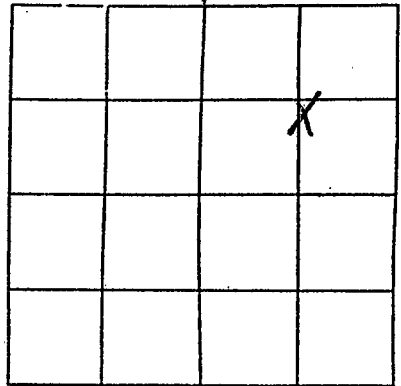

SECTION 26

Please indicate well location X.

Pump Capacity (GPM)	No. of Stages	Setting Depth
<u>10</u>	<u>9</u>	<u>75</u> FT.
PUMP TEST		
Well yielded <u>11</u> GPM with		
a drawdown of <u>1</u> ft.		
after <u>1</u> hours of pumping		

LOG DATA

TYPE OF LOG RUN (Circle One):	No Log Run,
Electric, Gamma Ray, Density, Sonic, Neutron,	
Other (Describe) _____	
Name of Organization Running Log _____	

GEOLOGIC DATA (Office Use Only)

Surface Elev.	Geologic Unit	Unit Thickness	Depth to Top
Subs. SWL	Date	Analysis	Aquifer Test

Driller's Remarks

If more than one screen, show location of each on sketch.