

Lincoln  
 NI  
 8-67

MISSISSIPPI  
 BOARD OF WATER COMMISSIONERS  
 416 North State Street  
 Jackson, Mississippi 39201

CODED

WATER WELL DRILLERS LOG

Aug 8 1967 Keener Well Drilling Lincoln  
 date well completed firm name county well located

LANDOWNER: Alfred Sykes  
 PFD  
 Brookham  
 (mailing address)

description of formations encountered	from	to
yellow clay	0	18
yellow sand	18	70
clay	70	75
coarse sand on top of chalk	75	85

WELL LOCATION:  
 sec 16 N R 9 E  
 7 miles SE of Brookham  
 (distance) (direction) (nearest town)

WELL PURPOSE: home  
 (home, irrigation, municipal, industrial)


WELL COMPLETION DATA:

- (1) diameter (inches) 4"
- (2) total depth (feet) 85
- (3) static water level (feet) 60 below top of ground
- (4) casing Plastic Bottom (material) (depth)
- (5) screen 6' 79' (length) (depth to top)  
 4" Plastic (size) (material)
- (6) pump ed pump (HP) (yield gpm)  
 2 1/2 (type power)
- (7) electric log No (yes or no)

CODED


(8) how well bottom plugged  
 wooden plug

DRILLERS REMARKS:  
 No Keener well at location

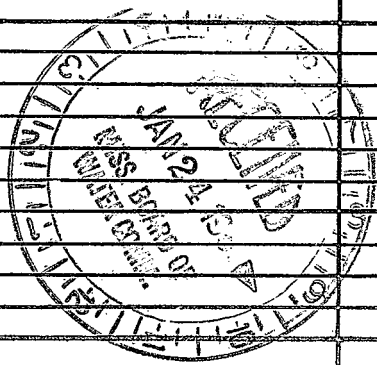

If well telescopes please sketch and show depths.

GROUND LEVEL

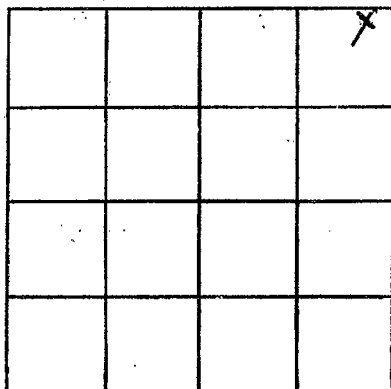

SECTION 17

Please indicate well location X.

ADDITIONAL INFORMATION

If more than one screen, show locations of each on sketch.