

LINCOLN
N2

MISSISSIPPI
BOARD OF WATER COMMISSIONERS
416 North State Street
Jackson, Mississippi 39201

WATER WELL DRILLERS LOG

2-16 1968 date well completed
General Water Well Serv. Lincoln firm name
Lincoln county well located

LANDOWNER: H.P. Norwood
Rt 4 Brookhaven Miss
(mailing address)


description of formations encountered	from	to
Top soil & clay	0	10
Sand	10	40
Chalk	40	46
Orange sand	46	66
White chalk	66	128
Finest medium sand	128	177
General sand	177	180
Chalk	180	

WELL LOCATION:
sec. 12 T 6 N R 9 E
12 miles E-SE of Brookhaven
(distance) (direction) (nearest town)

WELL PURPOSE: home
(home, irrigation, municipal, industrial)

- WELL COMPLETION DATA:
- (1) diameter (inches) 4
 - (2) total depth (feet) 180
 - (3) static water level (feet) 80 below top of ground.
 - (4) casing plastic 174 (material) (depth)
4 (size) if telescope see back.
 - (5) screen 6' 174 (length) (depth to top)
4 plastic (size) (material)
 - (6) pump 1/2 sub 12 (HP) (yield gpm)
3/4 (type power)
 - (7) electric log no (yes or no)
(organization running log)
 - (8) how well bottom plugged well peg


CODED

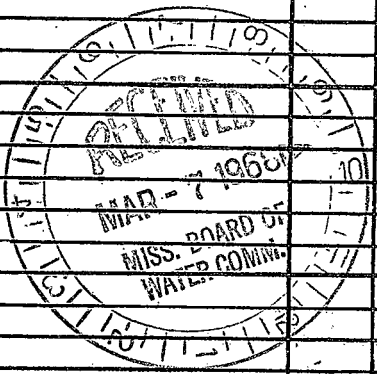

DRILLERS REMARKS:

If well telescopes please sketch and show depths.

GROUND LEVEL

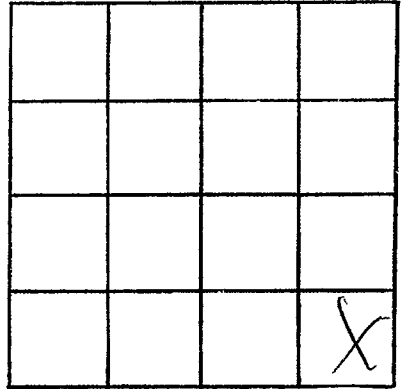

SECTION 12

Please indicate well location X.

ADDITIONAL INFORMATION

If more than one screen,
show locations of each on sketch.