

LINCOLN MISSISSIPPI BOARD OF WATER COMMISSIONERS

OK'd  
10/17/68

J N3 CODED

9-22-65

WATER WELL DRILLERS LOG

LINCOLN

Date: 9-22, 1965, Driller: J. T. Cooney Franklin County Franklin  
(Name)

(1) Owner of Land: Jeff Gill Est  
(Name)  
Brookhaven, Miss  
(Address)

(2) Location: 1/4, 1/4, Sec. 35 T6R9  
NE  
8 miles SW of Brookhaven  
(distance) (direction) (Nearest Town)

(3) Topography: Hilly  
(Hilly) (Flat) (Level)

(4) Purpose of Well: Domestic  
(Domestic Irrigation  
Municipal, Industrial, Other)

Description & Color of Materials Sand, Clay, Red Clay, Shell, etc.	Thickness Feet	Depth Feet
<u>Sandy Clay</u>	<u>20</u>	<u>20</u>
<u>SAND &amp; ROCK</u>	<u>30</u>	<u>50</u>
<u>Chalk</u>	<u>80</u>	<u>130</u>
<u>SANDS</u>	<u>21</u>	<u>151</u>

Information upon completion of well:

(1) Diameter 4" inches.

(2) Total Depth 151 feet.

(3) Water Level 50' feet below top of ground.


(4) Cased to 151, Size 4"

(5) Screen: Size 4", Length 6'

(6) Were any formations sealed against pollution?  
no

*Top doesn't agree with distance. Comm. to ...*

CODED

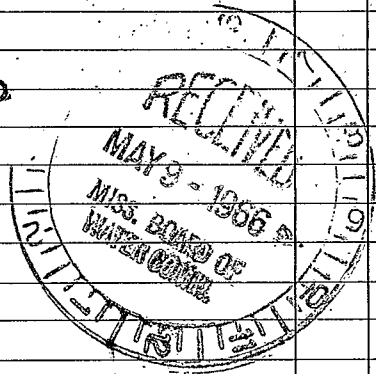

If YES depth of formation \_\_\_\_\_

Why \_\_\_\_\_

Drillers Remarks: \_\_\_\_\_

(Use Back Side)

Well No.

