

LINCOLN
N 7
5-27-74

MISSISSIPPI
 BOARD OF WATER COMMISSIONERS **CODED**
 416 North State Street
 Jackson, Mississippi 39201

WATER WELL DRILLERS LOG

May 27 1974 Grenn Water Well Lincoln
 date well completed firm name county well located

LANDOWNER: David Townsend
P.O. B x 14, Ruth, Mkss.

description of formations encountered
citronelle from 0 to 144

(mailing address)

WELL LOCATION:

sec. 13 T. 6 (N) R. 9 (E)
 3 miles E of East Lincoln
 (distance) (direction) (nearest town)

CODED

WELL PURPOSE: home
 (home, irrigation, municipal, industrial)

WELL COMPLETION DATA:

- (1) diameter (inches) 6"
- (2) total depth (feet) 144
- (3) static water level (feet) 65 below top of ground.
- (4) casing PVC 138
 (material) (depth)
4" if telescope see back.
 (size)
- (5) screen 6" 138
 (length) (depth to top)
.010, PVC
 (size) (material)
- (6) pump 1/2 sub 7
 (HP) (yield gpm)
electric
 (type power)
- (7) electric log no
 (yes or no)
- (8) how well bottom plugged wood


INDUSTRIAL WATER
 JACKSON, MISSISSIPPI

DRILLERS REMARKS:

MAY 27 1974

If well telescopes please sketch and show depths.

GROUND LEVEL

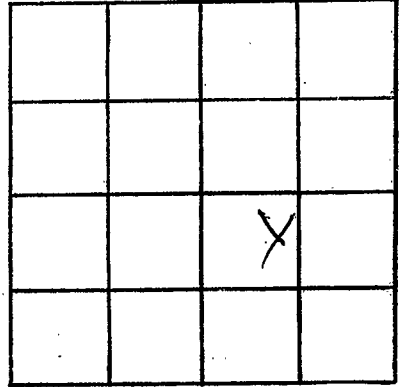

SECTION 13

Please indicate well location X.

ADDITIONAL INFORMATION

If more than one screen,
show locations of each on sketch.