

LINCOLN
N 8
4-24-74

MISSISSIPPI
 BOARD OF WATER COMMISSIONERS
 416 North State Street
 Jackson, Mississippi 39201

CODED

WATER WELL DRILLERS LOG

April 24 1974 Grenn Water Well Cont. Lincoln
 date well completed firm name county well located


LANDOWNER:	description of formations encountered	from	to
Melvin Mason Ruth, Miss.	Citronelle	0	100
(mailing address)	CODED		
WELL LOCATION:			
sec. 20 T 6 N R 9 E			
3 miles W of E. Lincoln			
(distance) (direction) (nearest town)			
WELL PURPOSE: home (home, irrigation, municipal, industrial)			
WELL COMPLETION DATA:			
(1) diameter (inches) 8 1/2 6"			
(2) total depth (feet) 100			
(3) static water level (feet) 65 below top of ground.			
(4) casing PVC 94 (material) (depth) 4" if telescope see back. (size)			
(5) screen 6 94 (length) (depth to top) .010 PVC (size) (material)			
(6) pump did not install (HP) (yield gpm) (type power)			
(7) electric log no (yes or no) (organization running log)			
(8) how well bottom plugged wood			
DRILLERS REMARKS:			

RECEIVED
 APR 27 1974

MISS. BD. OF WATER COMMISSIONERS

If well telescopes please sketch and show depths.

GROUND LEVEL

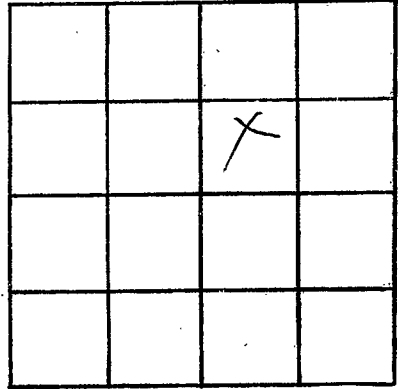

SECTION 20

Please indicate well location X.

ADDITIONAL INFORMATION

If more than one screen,
show locations of each on sketch.