

LINCOLN
N 9
5-27-74

MISSISSIPPI
 BOARD OF WATER COMMISSIONERS
 416 North State Street
 Jackson, Mississippi 39201

CODED

WATER WELL DRILLERS LOG

May 27 1974 Grenn Water Well Cont. Lincoln
 date well completed firm name county well located

LANDOWNER: Melvin Mason
 Ruth, Miss. description of formations encountered Citronelle from 0 to 105

(mailing address)

CODED

WELL LOCATION:
 sec 20 T 6 R 9
 3 miles W of E. Lincoln
 (distance) (direction) (nearest town)

WELL PURPOSE: home
 (home, irrigation, municipal, industrial)

- WELL COMPLETION DATA:
- (1) diameter (inches) 6"
 - (2) total depth (feet) 105
 - (3) static water level (feet) 70 below top of ground.
 - (4) casing PVC 99' (material) (depth)
 4" (size) If telescope see back.
 - (5) screen 6' 99ft. (length) (depth to top)
 .010 PVC (size) (material)
 - (6) pump did not install (HP) (yield gpm)
 - (7) electric log no (yes or no)
 - (8) how well bottom plugged wodd


RECEIVED
 JUN 27 1974

MISS. Bd. OF WATER COMM.

DRILLERS REMARKS:

If well telescopes please sketch and show depths.

GROUND LEVEL

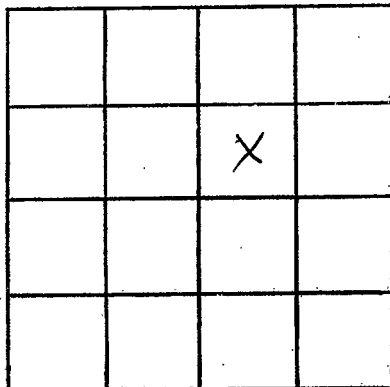

SECTION 20

Please indicate well location X.

ADDITIONAL INFORMATION

If more than one screen,
show locations of each on sketch.