

LINCOLN  
N 10  
4-23-74

MISSISSIPPI  
BOARD OF WATER COMMISSIONERS  
416 North State Street  
Jackson, Mississippi 39201

CODED

WATER WELL DRILLERS LOG

April 23 19 74 Grenn Water Well Cont. Lincoln  
date well completed firm name county well located

LANDOWNER: Clifford Hebert  
213 Briarwodd Drive  
Gretna, La. 70053  
(mailing address)

description of formations encountered  
Citronelle

from 0 to 94

WELL LOCATION:

sec 28 T 6 N R 9 E  
S W  
3 miles W of E. Lincoln  
(distance) (direction) (nearest town)

CODED

WELL PURPOSE: home  
(home, irrigation, municipal, industrial)

WELL COMPLETION DATA:

- (1) diameter (inches) 6"  
94"
- (2) total depth (feet) 94"
- (3) static water level (feet) 70' below top of ground.
- (4) casing PVC 88'  
(material) (depth)  
4" If telescope see back.  
(size)
- (5) screen 6' 88'  
(length) (depth to top)  
.010 PVC  
(size) (material)
- (6) pump 1/2 sub 7  
(HP) (yield gpm)  
electric  
(type power)
- (7) electric log no  
(yes or no)

(organization running log)

(8) how well bottom plugged wood


RECEIVED  
APR 27 1974

DRILLERS REMARKS:

MISS. BOARD OF WATER COMMISSIONERS

If well telescopes please sketch and show depths.

GROUND LEVEL

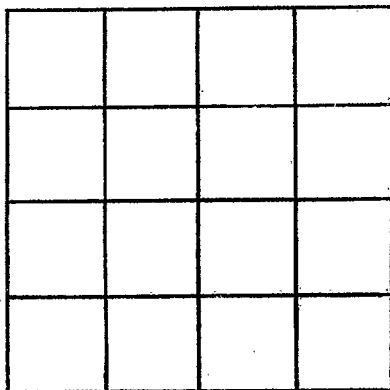

SECTION 28

Please indicate well location X.

ADDITIONAL INFORMATION

If more than one screen, show locations of each on sketch.

L