

Lincoln
 NII
 9-29-79

MISSISSIPPI
 BOARD OF WATER COMMISSIONERS
 416 North State Street
 Jackson, Mississippi 39201

CODED

WATER WELL DRILLERS LOG

Sept 24 1974 Chester Reeves Lincoln
 date well completed firm name county well located

LANDOWNER: J. E. Farmer
 RFD - Brookhaven

description of formations encountered	from	to
clay	0	17
Red Sand	17	50
sand & gravel	50	58
blue chalk	58	159
cross white sand	159	180

(mailing address)

WELL LOCATION:
 sec. 6 T. 6 N. R. 9 E.
 6 miles SE of Brookhaven
 (distance) (direction) (nearest town)

WELL PURPOSE: Home
 (home, irrigation, municipal, industrial)

- WELL COMPLETION DATA:
- (1) diameter (inches) 4"
 - (2) total depth (feet) 180
 - (3) static water level (feet) 105 below top of ground.
 - (4) casing 2" galv. bottom (material) (depth)
 - (size) If telescope see back.
 - (5) screen 6" 174 (length) (depth to top)
 - 4" galv. (size) (material)
 - (6) pump 1/2 Sub 10 (HP) (yield gpm)
 - 3/4" (type power)
 - (7) electric log No (yes or no)

(organization running log)

(8) how well bottom plugged
 wooden plug

DRILLERS REMARKS:
 new location


RECEIVED
 10/31/74

OCT 31 1974

MISS. BD. OF WATER COMM.

If well telescopes please sketch and show depths.

GROUND LEVEL

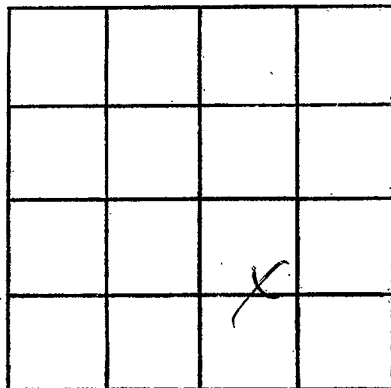

SECTION 6

Please indicate well location X.

ADDITIONAL INFORMATION

If more than one screen, show locations of each on sketch.